


T. 24 S., R. 7 W., W.M., Section 17

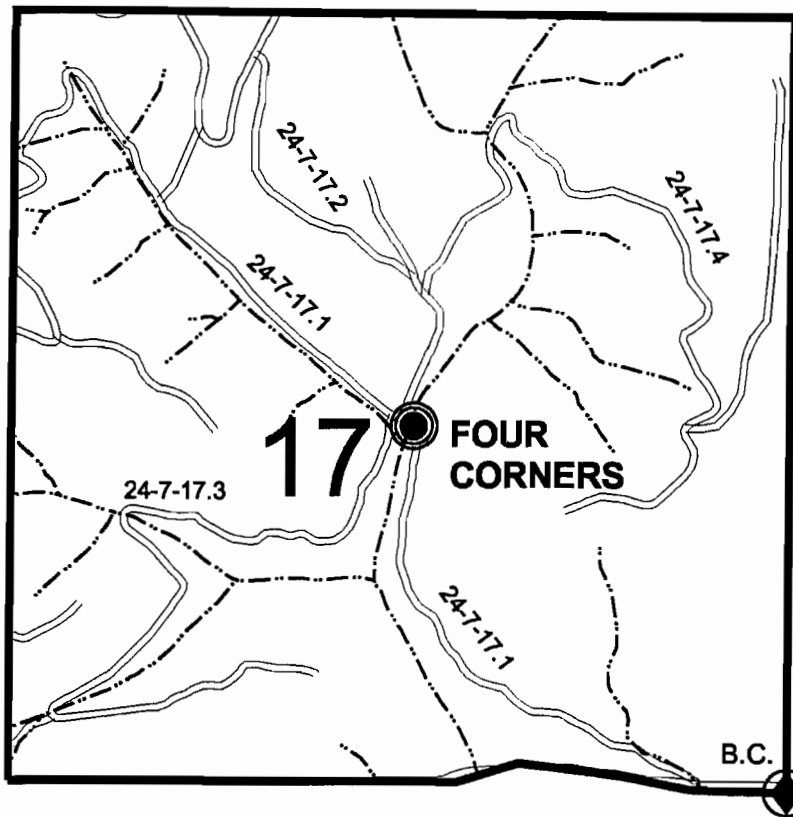

SCALE:
1" = 1320'



Diversion is:
2512 ft. North and
2565 ft. West of the
SE cor. Sec 17


CLAIM OF BENEFICIAL USE MAP

in name of

UNITED STATES BUREAU OF LAND MANAGEMENT

RECEIVED Application No.: R - 71505
S - 71506
SEP 25 2000 Permit No.: R - 12047
52823

WATER RESOURCES DEPT.
SALEM, OREGON

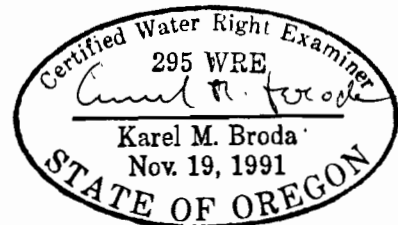

SURVEYED: May 6, 2000

Expires: 12/31/01

THIS MAP WAS PREPARED FOR THE PURPOSE OF IDENTIFYING THE LOCATION OF A WATER RIGHT ONLY
AND IS NOT INTENDED TO PROVIDE LEGAL DIMENSIONS OR LOCATION OF PROPERTY OWNERSHIP LINES.

U.S. Bureau of Land Management
Roseburg District Office
Division of Operations

Executed by:
Karel M. Broda, PE, CWRE
777 N.W. Garden Valley Blvd.
Roseburg, Oregon 97470