


# T. 32 S., R. 7 W., W.M., Section 13

**Diversion is:**  
**951 ft. South and**  
**1355 ft. East of the**  
**NW cor. Sec 13**

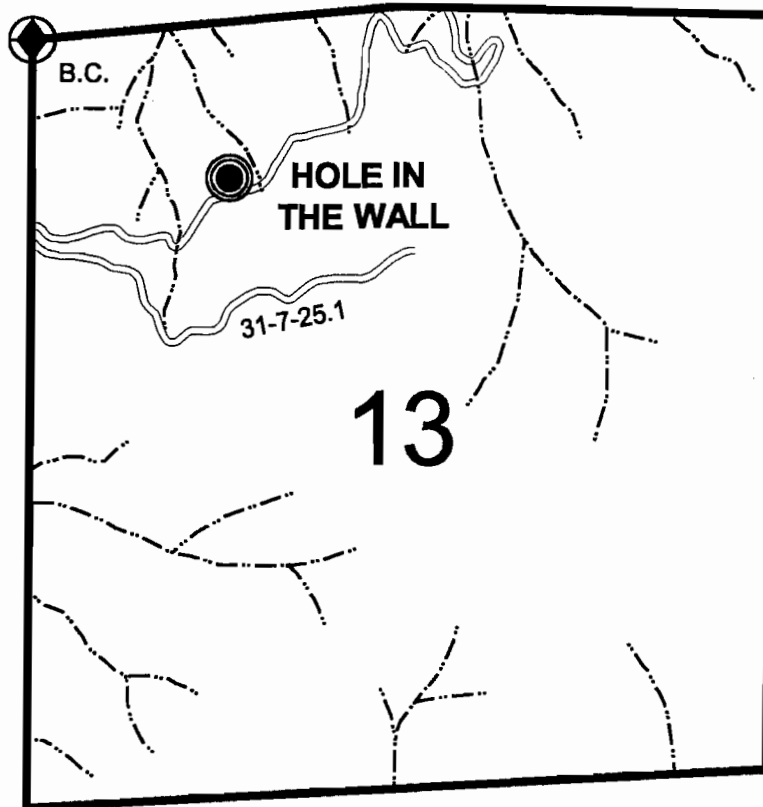

**N**

**SCALE:**  
**1" = 1320'**

## CLAIM OF BENEFICIAL USE MAP

in name of

**UNITED STATES BUREAU OF LAND MANAGEMENT**

**Application No.: R - 71866**

**S - 71867**

**Permit No.: R - 11793**

**52261**

**RECEIVED**

**SEP 25 2000**

**WATER RESOURCES DEPT.**  
**SALEM, OREGON**

**SURVEYED: June 6, 2000**



**Expires: 12/31/01**

**THIS MAP WAS PREPARED FOR THE PUPOSE OF IDENTIFYING THE LOCATION OF A WATER RIGHT ONLY**  
**AND IS NOT INTENDED TO PROVIDE LEGAL DIMENSIONS OR LOCATION OF PROPERTY OWNERSHIP LINES.**

**U.S. Bureau of Land Management**  
**Roseburg District Office**  
**Division of Operations**

**Executed by:**  
**Karel M. Broda, PE, CWRE**  
**777 N.W. Garden Valley Blvd.**  
**Roseburg, Oregon 97470**