


T. 25 S., R. 3 W., W.M., Section 23

Diversion is:
361 ft. North and
128 ft. East of the
SW cor. Sec 23

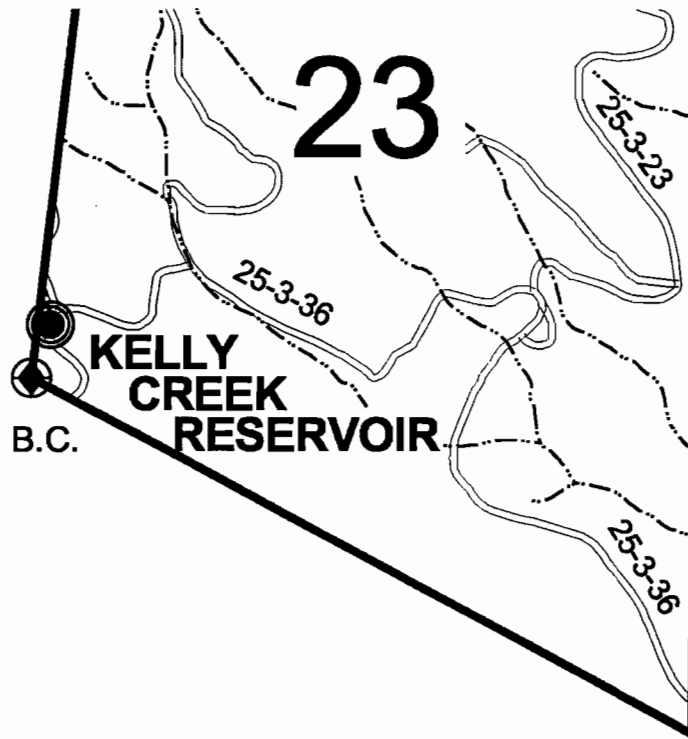

SCALE:
1" = 1320'

CLAIM OF BENEFICIAL USE MAP

in name of


UNITED STATES BUREAU OF LAND MANAGEMENT

Application No.: R - 71844

S - 71845

Permit No.: R - 11806

52258

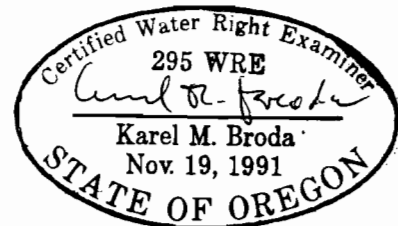

Expires: 12/31/01

SURVEYED: May 9, 2000

THIS MAP WAS PREPARED FOR THE PUPOSE OF IDENTIFYING THE LOCATION OF A WATER RIGHT ONLY
AND IS NOT INTENDED TO PROVIDE LEGAL DIMENSIONS OR LOCATION OF PROPERTY OWNERSHIP LINES.

U.S. Bureau of Land Management
Roseburg District Office
Division of Operations

Executed by:
Karel M. Broda, PE, CWRE
777 N.W. Garden Valley Blvd.
Roseburg, Oregon 97470