


# T. 25 S., R. 3 W., W.M., Section 23



SCALE:  
1" = 1320'

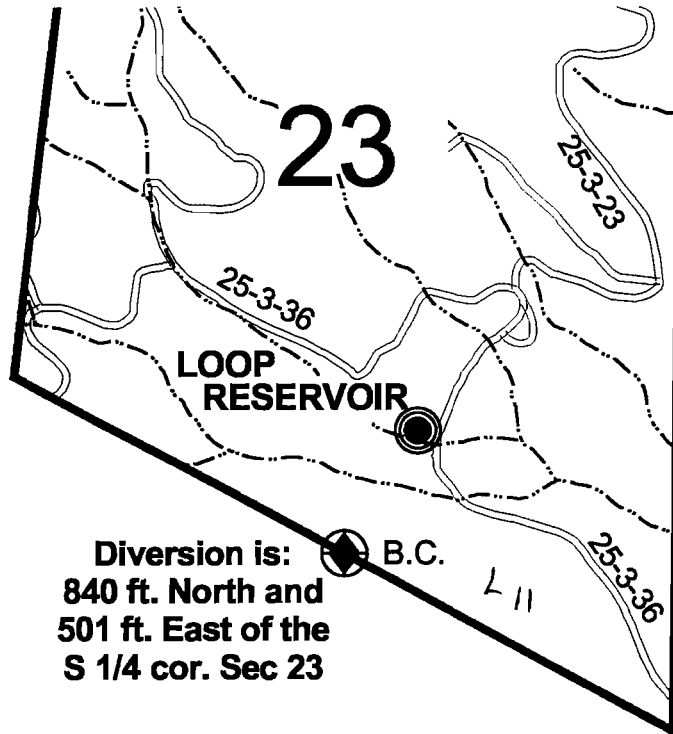

Diversion is:  B.C.  
840 ft. North and  
501 ft. East of the  
S 1/4 cor. Sec 23

## CLAIM OF BENEFICIAL USE MAP

in name of

UNITED STATES BUREAU OF LAND MANAGEMENT

Application No.: R - 71846

S - 71847


**RECEIVED** Permit No.: R - 11795

52257

SEP 25 2000

WATER RESOURCES DEPT.  
SALEM, OREGON

**SURVEYED: May 9, 2000**

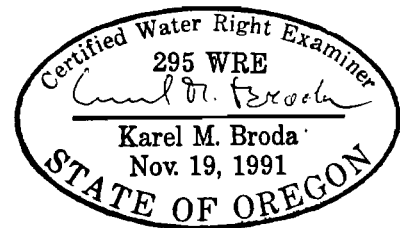

Expires: 12/31/01

THIS MAP WAS PREPARED FOR THE PURPOSE OF IDENTIFYING THE LOCATION OF A WATER RIGHT ONLY  
AND IS NOT INTENDED TO PROVIDE LEGAL DIMENSIONS OR LOCATION OF PROPERTY OWNERSHIP LINES.

U.S. Bureau of Land Management  
Roseburg District Office  
Division of Operations

Executed by:  
Karel M. Broda, PE, CWRE  
777 N.W. Garden Valley Blvd.  
Roseburg, Oregon 97470