


T. 30 S., R. 8 W., W.M., Section 27

Diversion is:
676 ft. South and
1125 ft. East of the
NW cor. Sec 27

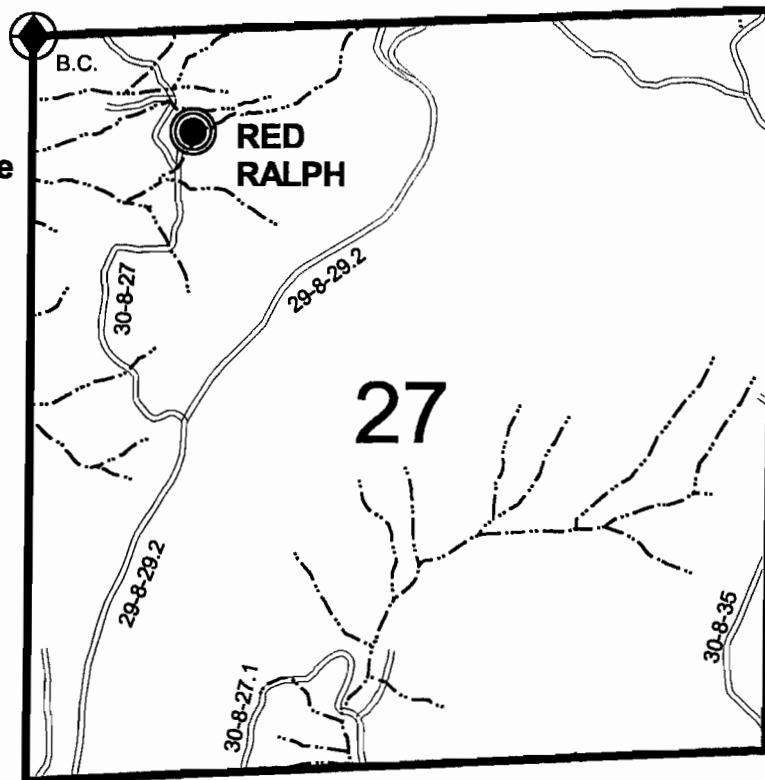

SCALE:
1" = 1320'

CLAIM OF BENEFICIAL USE MAP

in name of

UNITED STATES BUREAU OF LAND MANAGEMENT

Application No.: R - 70707

S - 70523


Permit No.: R - 11883

52478

RECEIVED

SEP 25 2000

WATER RESOURCES DEPT.
SALEM, OREGON

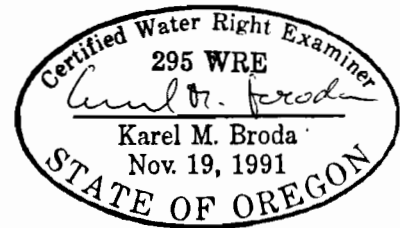

Expires: 12/31/01

SURVEYED: May 10, 2000

THIS MAP WAS PREPARED FOR THE PURPOSE OF IDENTIFYING THE LOCATION OF A WATER RIGHT ONLY
AND IS NOT INTENDED TO PROVIDE LEGAL DIMENSIONS OR LOCATION OF PROPERTY OWNERSHIP LINES.

U.S. Bureau of Land Management
Roseburg District Office
Division of Operations

Executed by:
Karel M. Broda, PE, CWRE
777 N.W. Garden Valley Blvd.
Roseburg, Oregon 97470