


T. 28 S., R. 8 W., W.M., Section 19 **RECEIVED**

MAY 24 2000

WATER RESOURCES DEPT.
SALEM, OREGON

Diversion is:
1628 ft. South and
1348 ft. West of the
NE cor. Sec. 19


SCALE:
1" = 1320'

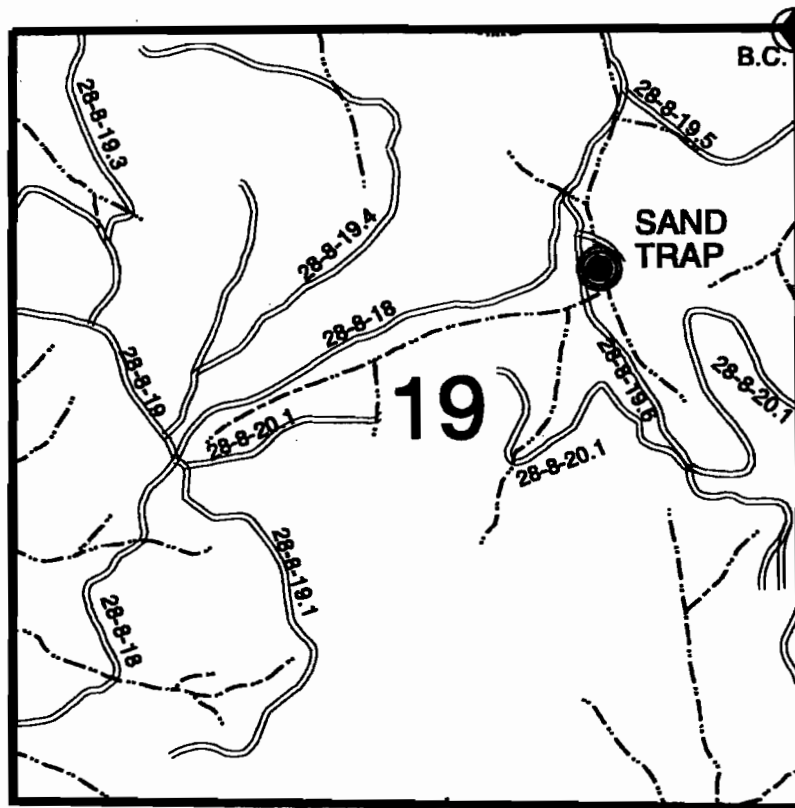


CLAIM OF BENEFICIAL USE MAP

in name of

UNITED STATES BUREAU OF LAND MANAGEMENT

Application No.: R - 70702
S - 70513

Permit No.: R - 11764
52038

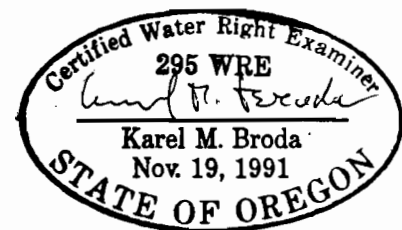

Expires: 12/31/01

SURVEYED: March 22, 2000

THIS MAP WAS PREPARED FOR THE PURPOSE OF IDENTIFYING THE LOCATION OF A WATER RIGHT ONLY
AND IS NOT INTENDED TO PROVIDE LEGAL DIMENSIONS OR LOCATION OF PROPERTY OWNERSHIP LINES.

U.S. Bureau of Land Management
Roseburg District Office
Division of Operations

Executed by:
Karel M. Broda, PE, CWRE
777 N.W. Garden Valley Blvd.
Roseburg, Oregon 97470