


T. 31 S., R. 9 W., W.M., Section 3

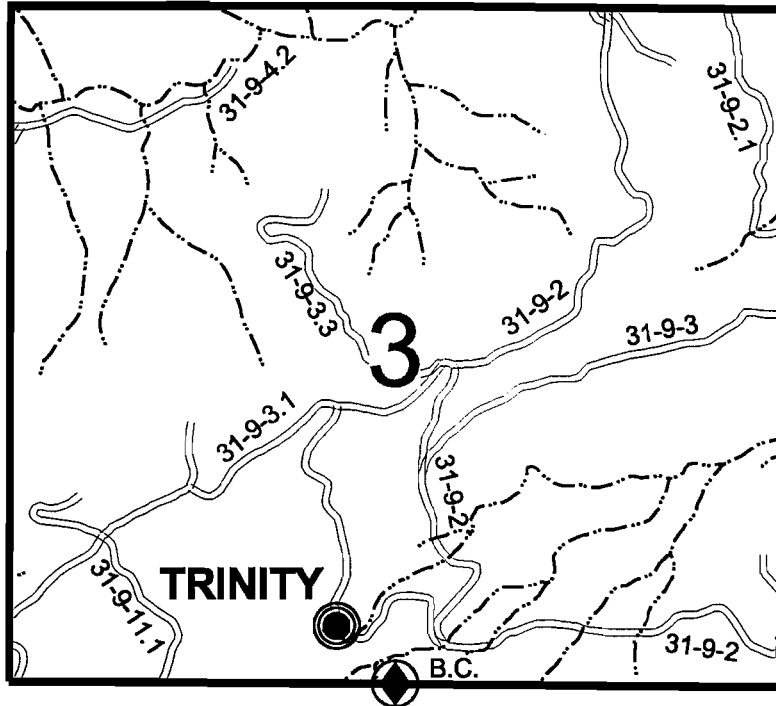

SCALE:
1" = 1320'



Diversion is:
397 ft. North and
397 ft. West of the
S 1/4 cor. Sec 3

RECEIVED

SEP 25 2000

WATER RESOURCES DEPT.
SALEM, OREGON

CLAIM OF BENEFICIAL USE MAP

in name of


UNITED STATES BUREAU OF LAND MANAGEMENT

Application No.: R - 70704

S - 70516

Permit No.: R - 11763

52113

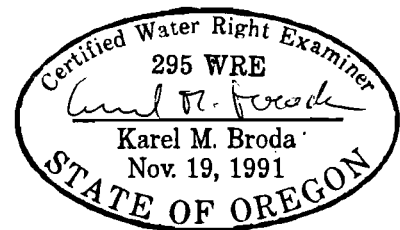

Expires: 12/31/01

SURVEYED: June 14, 2000

THIS MAP WAS PREPARED FOR THE PUPOSE OF IDENTIFYING THE LOCATION OF A WATER RIGHT ONLY
AND IS NOT INTENDED TO PROVIDE LEGAL DIMENSIONS OR LOCATION OF PROPERTY OWNERSHIP LINES.

U.S. Bureau of Land Management
Roseburg District Office
Division of Operations

Executed by:
Karel M. Broda, PE, CWRE
777 N.W. Garden Valley Blvd.
Roseburg, Oregon 97470