


T. 30 S., R. 6 W., W.M., Section 9

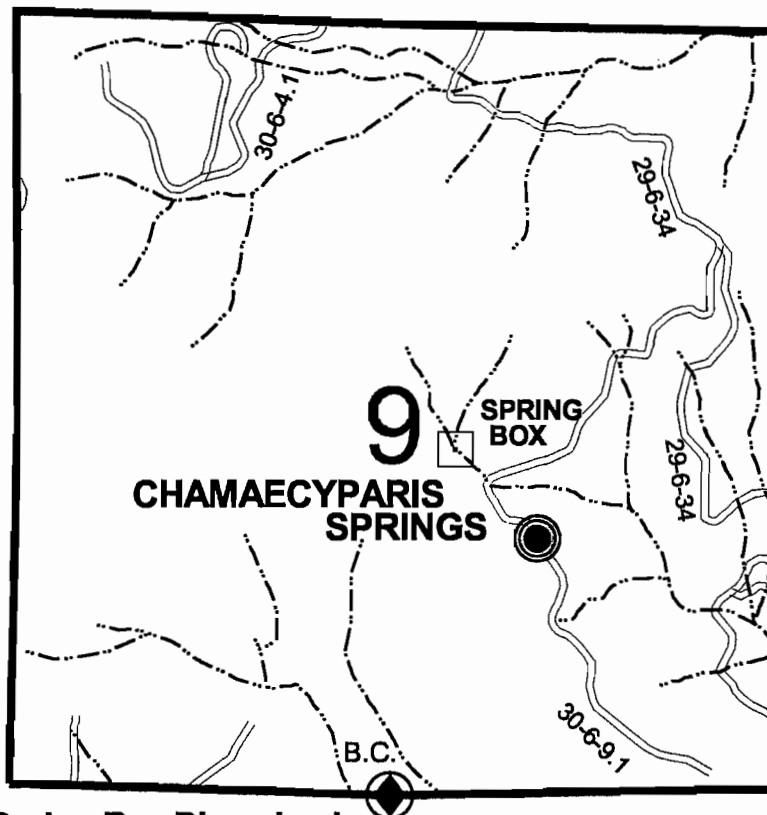

SCALE:
1" = 1320'



Spring Box Diversion is:
2362 ft. North and
440 ft. East of the
S 1/4 cor. Sec 9

Pond Diversion is:
1771 ft. North and
1014 ft. East of the
S 1/4 cor. Sec 9

CLAIM OF BENEFICIAL USE MAP

in name of

UNITED STATES BUREAU OF LAND MANAGEMENT

Application No.: R - 70710

RECEIVED

S - 70517

Permit No.: R - 12117

SEP 25 2000

53014

WATER RESOURCES DEPT.
SALEM, OREGON



Expires: 12/31/01

SURVEYED: May 23, 2000

THIS MAP WAS PREPARED FOR THE PURPOSE OF IDENTIFYING THE LOCATION OF A WATER RIGHT ONLY
AND IS NOT INTENDED TO PROVIDE LEGAL DIMENSIONS OR LOCATION OF PROPERTY OWNERSHIP LINES.

U.S. Bureau of Land Management
Roseburg District Office
Division of Operations

Executed by:
Karel M. Broda, PE, CWRE
777 N.W. Garden Valley Blvd.
Roseburg, Oregon 97470