


T. 29 S., R. 8 W., W.M., Section 5

RECEIVED

MAY 24 2000

WATER RESOURCES DEPT.
SALEM, OREGON

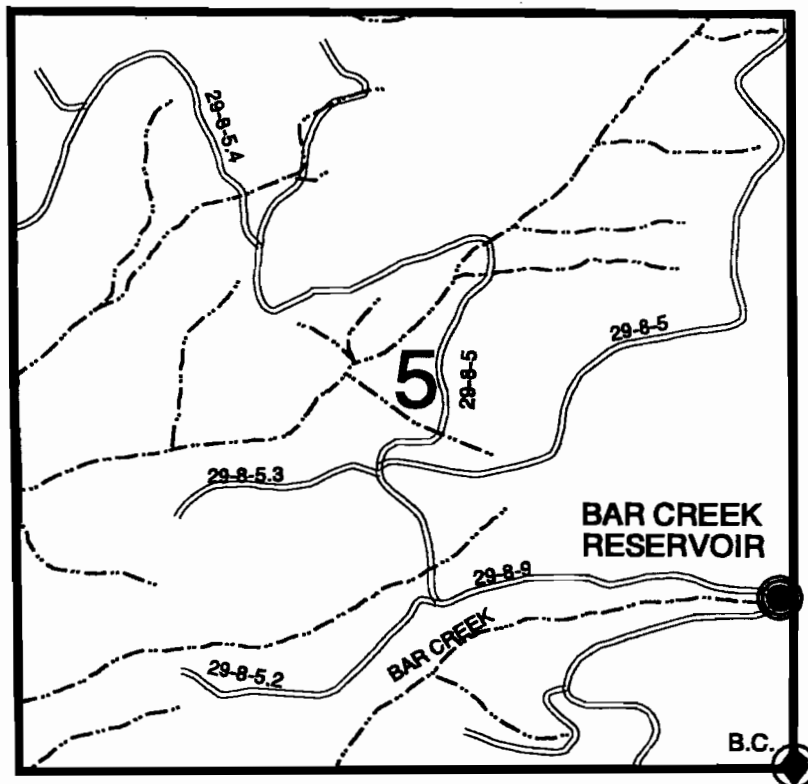

Diversion is:
1178 ft. North and
95 ft. West of the
SE cor. Sec. 5

SCALE:
1" = 1320'


CLAIM OF BENEFICIAL USE MAP

in name of

UNITED STATES BUREAU OF LAND MANAGEMENT

Application No.: R - 70706
S - 70522

Permit No.: R - 11882
52479

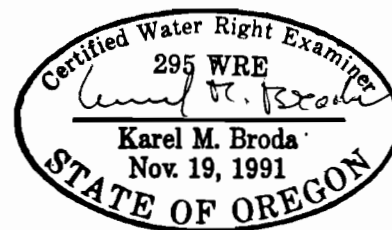

Expires: 12/31/01

SURVEYED: April 4, 2000

THIS MAP WAS PREPARED FOR THE PURPOSE OF IDENTIFYING THE LOCATION OF A WATER RIGHT ONLY
AND IS NOT INTENDED TO PROVIDE LEGAL DIMENSIONS OR LOCATION OF PROPERTY OWNERSHIP LINES.

U.S. Bureau of Land Management
Roseburg District Office
Division of Operations

Executed by:
Karel M. Broda, PE, CWRE
777 N.W. Garden Valley Blvd.
Roseburg, Oregon 97470