


# T. 29 S., R. 8 W., W.M., Section 29

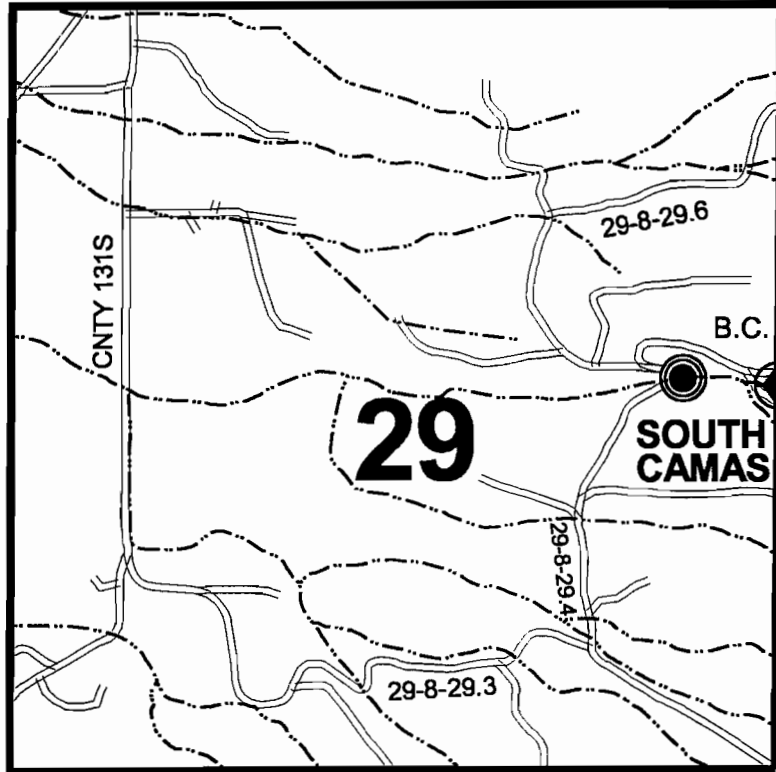

SCALE:  
1" = 1320'



Diversion is:  
49 ft. North and  
653 ft. West of the  
E 1/4 cor. Sec 29

## CLAIM OF BENEFICIAL USE MAP

in name of

UNITED STATES BUREAU OF LAND MANAGEMENT

Application No.: R - 71870


S - 71871

Permit No.: R - 11752

52112

**RECEIVED**

SEP 25 2000

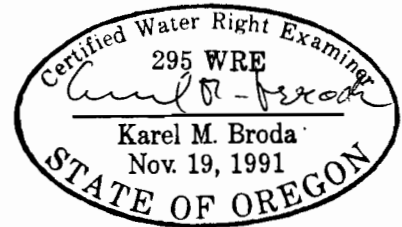

WATER RESOURCES DEPT.  
SALEM, OREGON

**SURVEYED: May 25, 2000**

Expires: 12/31/01

THIS MAP WAS PREPARED FOR THE PURPOSE OF IDENTIFYING THE LOCATION OF A WATER RIGHT ONLY  
AND IS NOT INTENDED TO PROVIDE LEGAL DIMENSIONS OR LOCATION OF PROPERTY OWNERSHIP LINES.

U.S. Bureau of Land Management  
Roseburg District Office  
Division of Operations

Executed by:  
Karel M. Broda, PE, CWRE  
777 N.W. Garden Valley Blvd.  
Roseburg, Oregon 97470