


# MAP SHOWING PARTS OF SECTION 3-4-9 & 10. T4 S.F

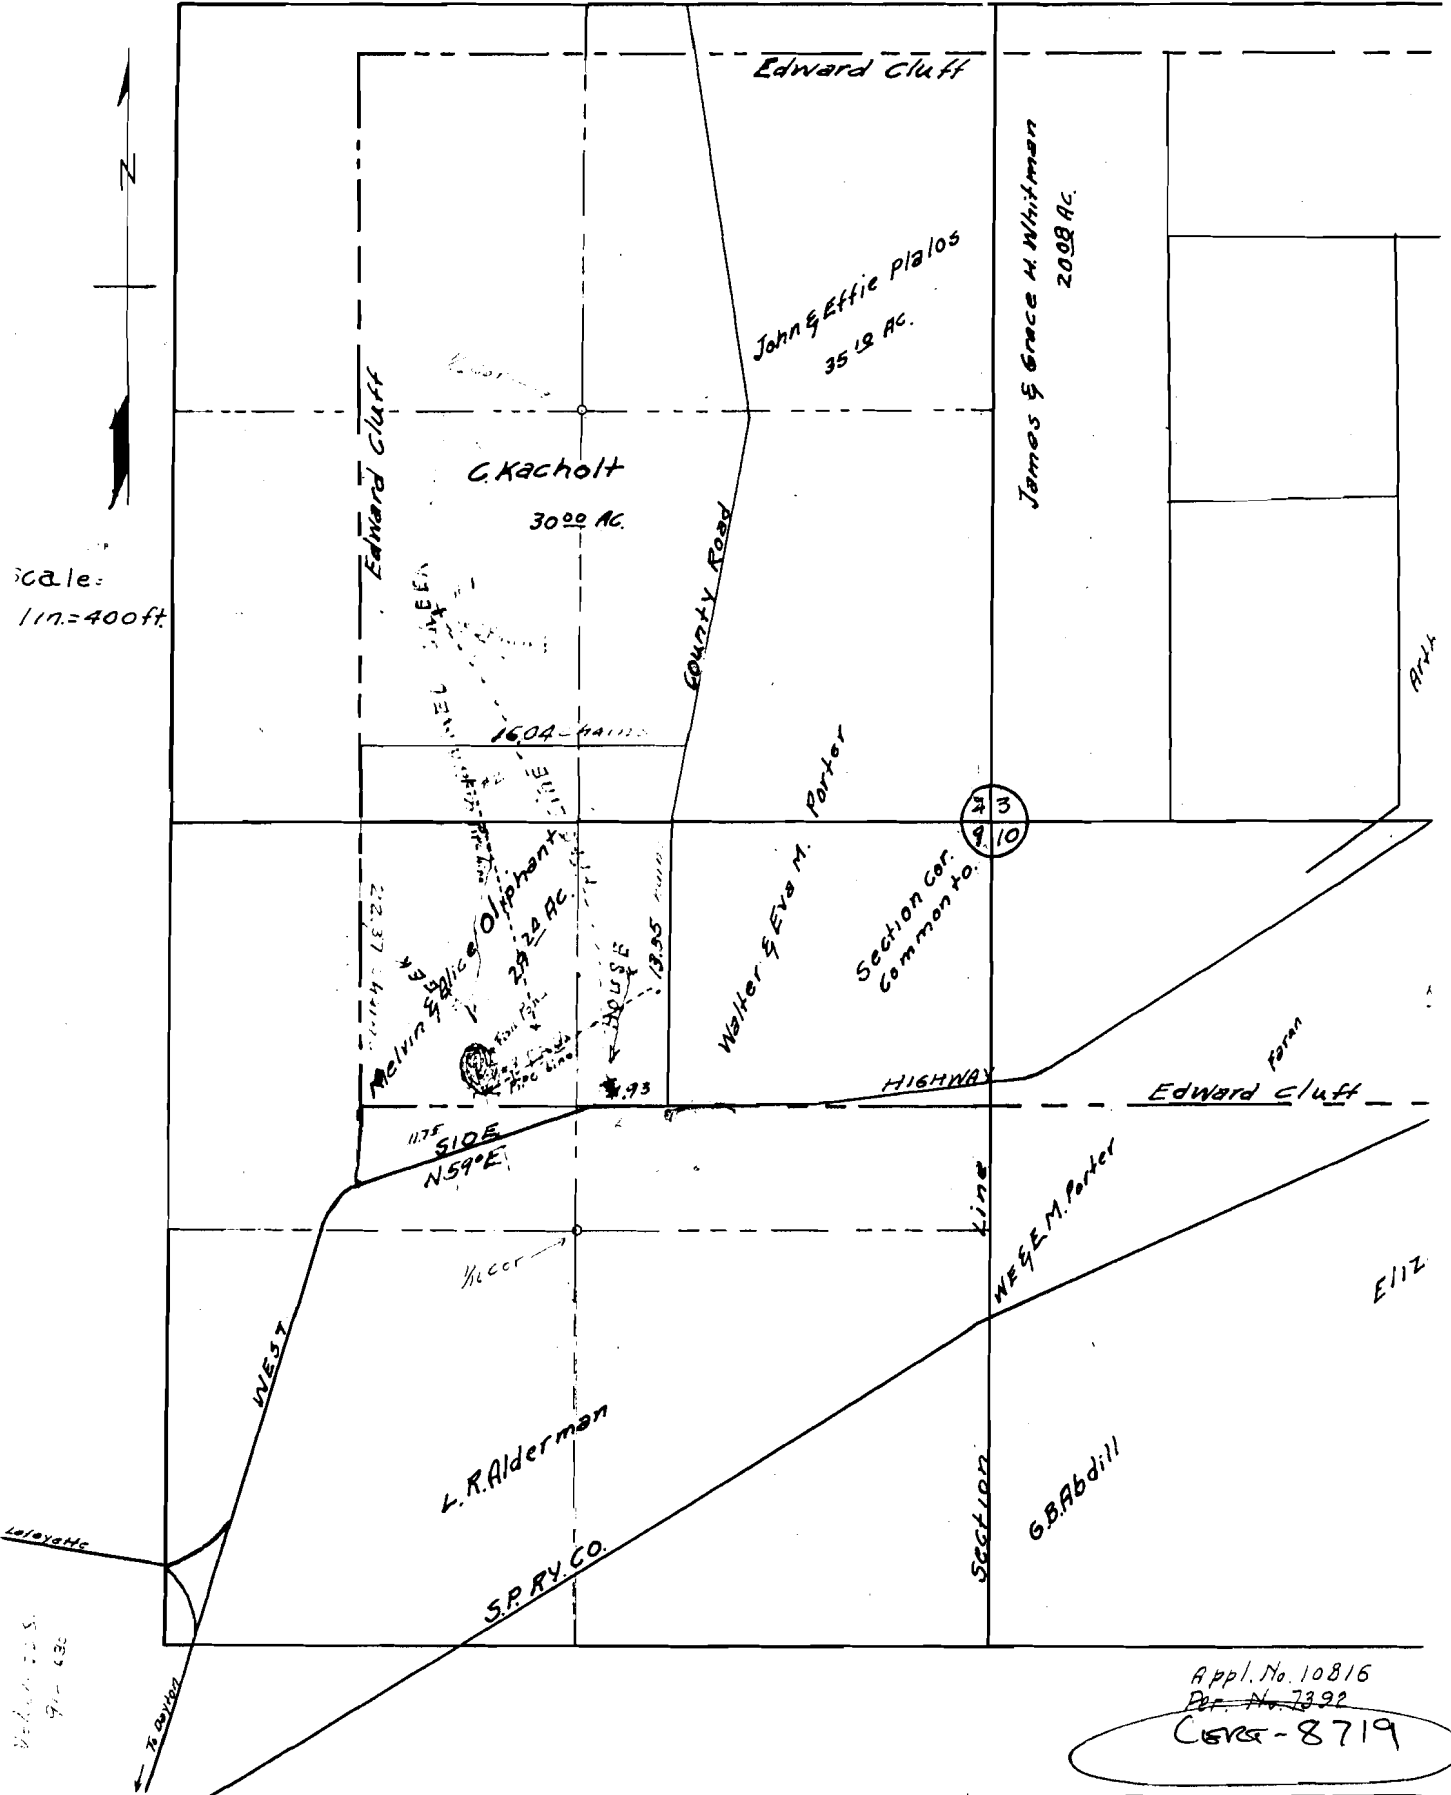

Appl. No. 10816  
 P. No. 7392  
