
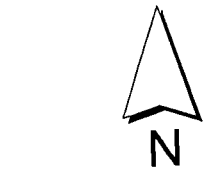


# T40S R8W

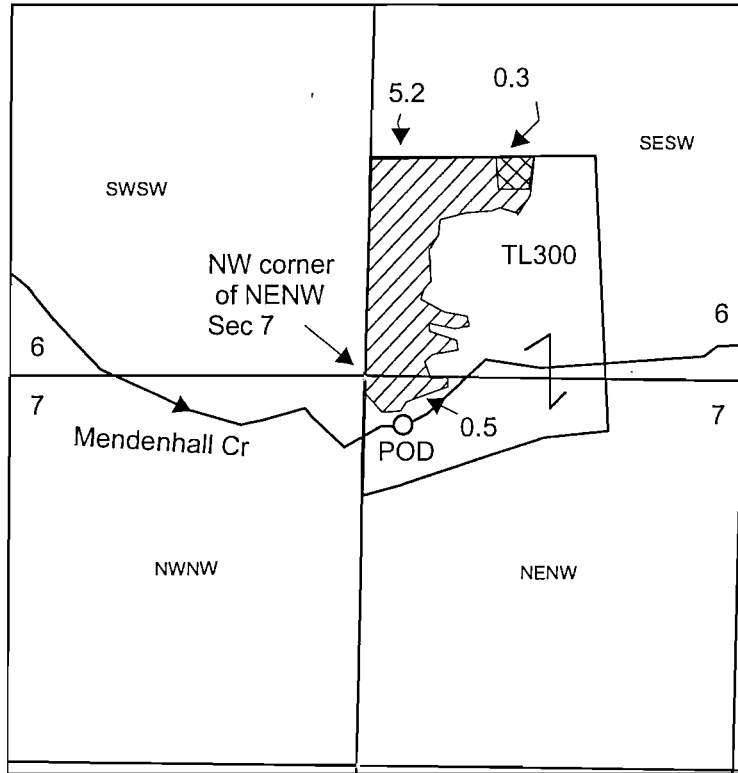


RECEIVED


APR 13 2011

WATER RESOURCES DEPT  
SALEM, OREGON

POD is located 138 ft east  
and 163 ft south from the  
northwest corner of the  
NENW quarter of  
T40S R8W Sec 7.

1 inch = 660 feet

Permit 44235 

Permit 43621 

## FINAL PROOF SURVEY

UNDER

Application No. 58629 Permit No. 44235

Application No. 57812 Permit No. 43621

IN NAME OF

**Ted Holman**

FSA09 K.Smith April 13, 2011