


T40S R8W

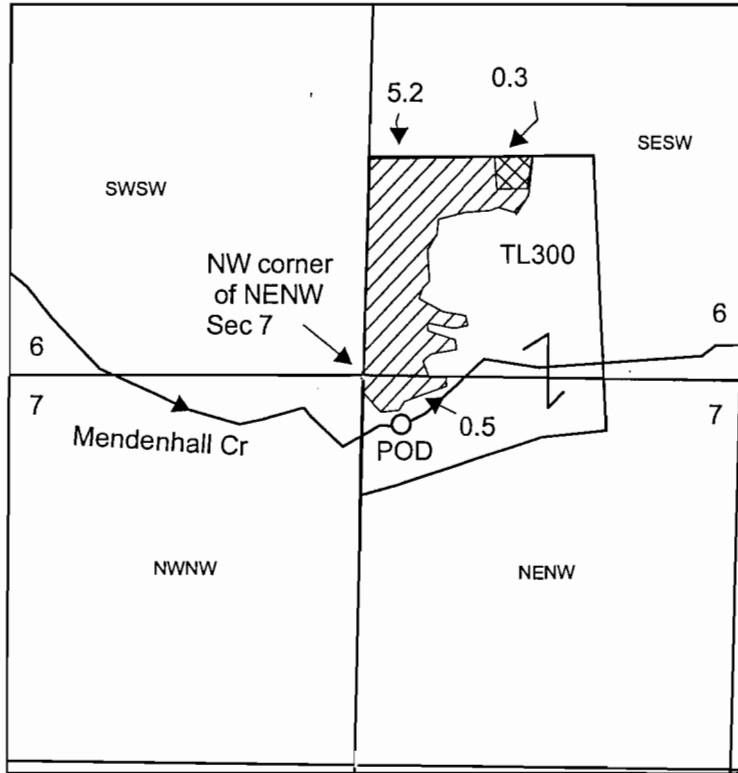


RECEIVED


APR 13 2011

WATER RESOURCES DEPT
SALEM, OREGON

POD is located 138 ft east
and 163 ft south from the
northwest corner of the
NENW quarter of
T40S R8W Sec 7.

1 inch = 660 feet

Permit 44235 

Permit 43621 

FINAL PROOF SURVEY

UNDER

Application No. 58629 Permit No. 44235

Application No. 57812 Permit No. 43621

IN NAME OF

Ted Holman

FSA09 K.Smith April 13, 2011