


Tax Lot No. TL300 22 12 34

Tax Lot No. TL301 23 12 3

Section 34 Township 22S Range 12W W.M. Douglas County

Section 3 Township 23S Range 12W W.M. Coos County

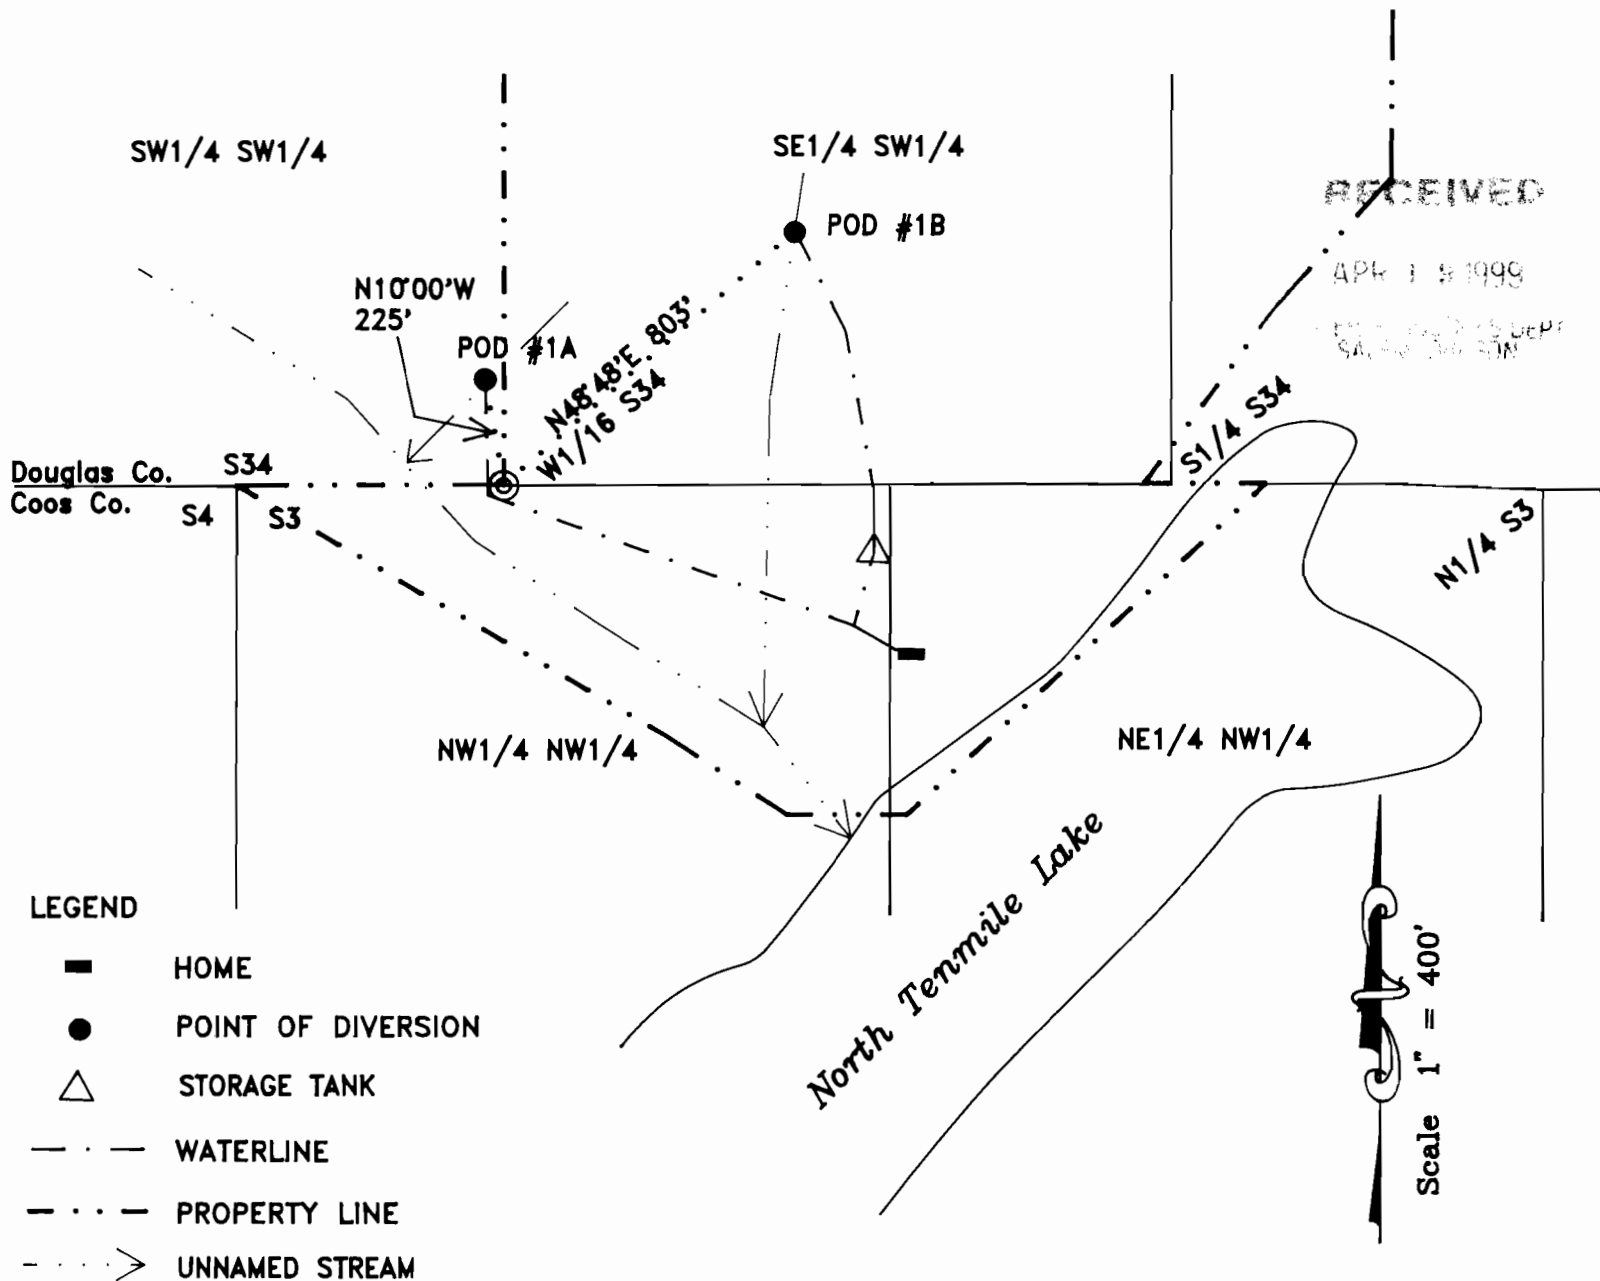

EXAMINERS DISCLAIMER STATEMENT

The preparation of this map was for the purpose of identifying the location of the Water Right only and has no intent to provide dimensions or location of property ownership lines.

FINAL PROOF SURVEY

IN THE NAME OF

Sarah K. Thomas

Surveyed on 2/16/99 by H.A. Wilcox

Application No. S-80905
Permit No. 52950

