


SECTION 9 T4S R3W W.M.
YAMHILL COUNTY

1" = 400'

RECEIVED

OCT 06 2004

WATER RESOURCES DEPT
SALEM, OREGON

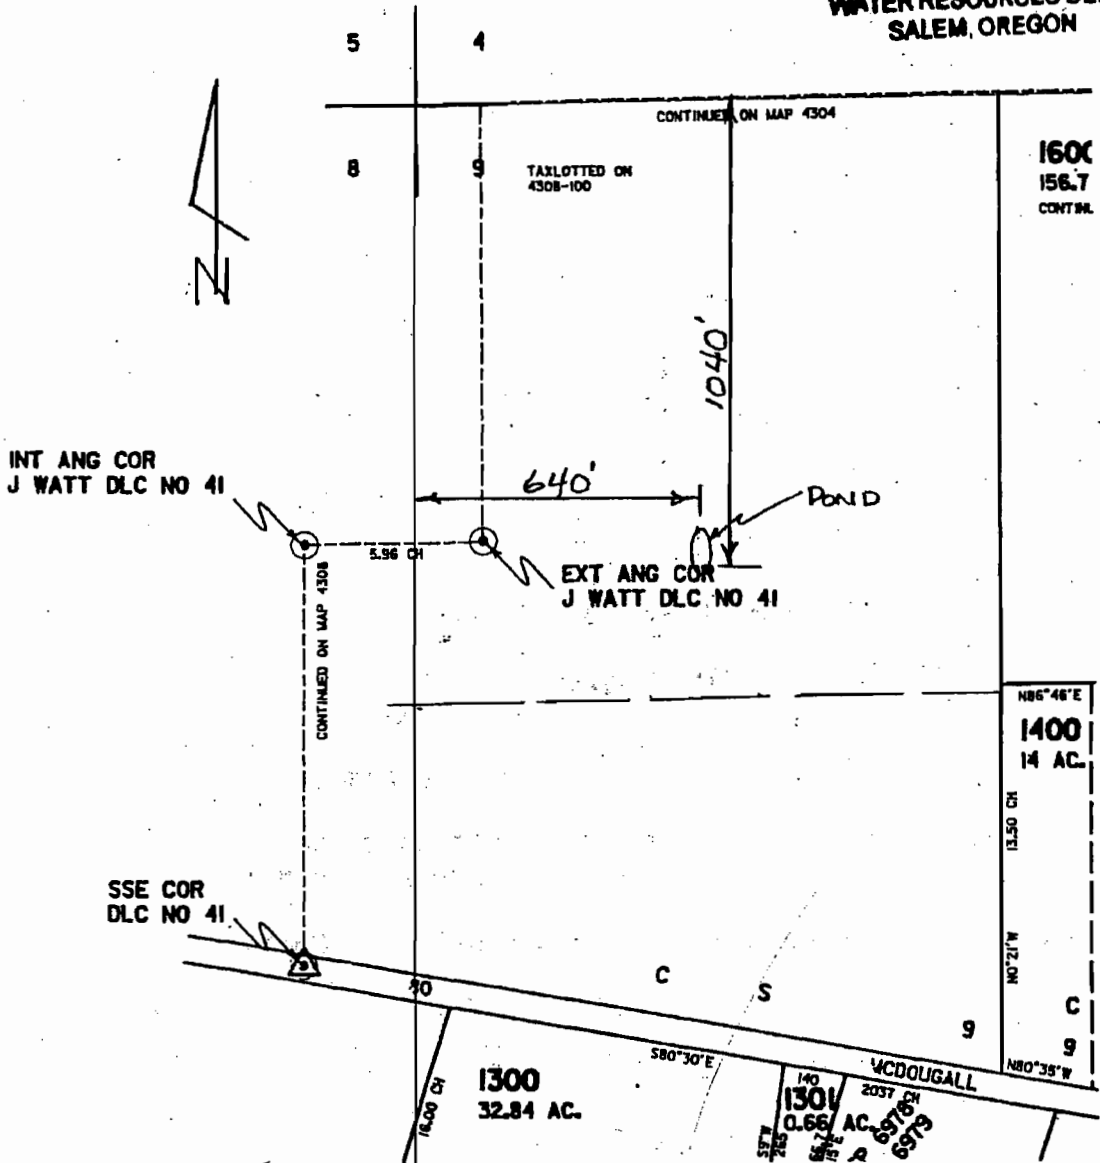

Certified Water Right Examiner
#138
W. Richard Verboort
W. Richard Verboort
Nov. 19, 1987
STATE OF OREGON

PREPARATION OF THIS MAP IS FOR THE
PURPOSE OF IDENTIFYING THE LOCATION OF
THE WATER RIGHT ONLY. THERE IS NO INTENT
TO PROVIDE DIMENSIONS OR LOCATION OF
PROPERTY OWNERSHIP LINES.

RECEIVED

NOV 08 2010

WATER RESOURCES DEPT
SALEM, OREGON

VERBOORT ENGINEERING
AGRICULTURE-CIVIL-WATER RESOURCES
HILLSBORO, OREGON

by date
designed *RV* 9-04
drawn
checked *RV* 9-04
drawing no. 04-A-10
sheet no. 1/2

RESERVOIR APPLICATION
RED HILLS FARM LLC
15909 NE McDOUGALL RD
DAYTON, OR 97114