


SCALE  
1" = 800'



SEE MAP NO 6 6 28



SEE MAP NO 6 6 28

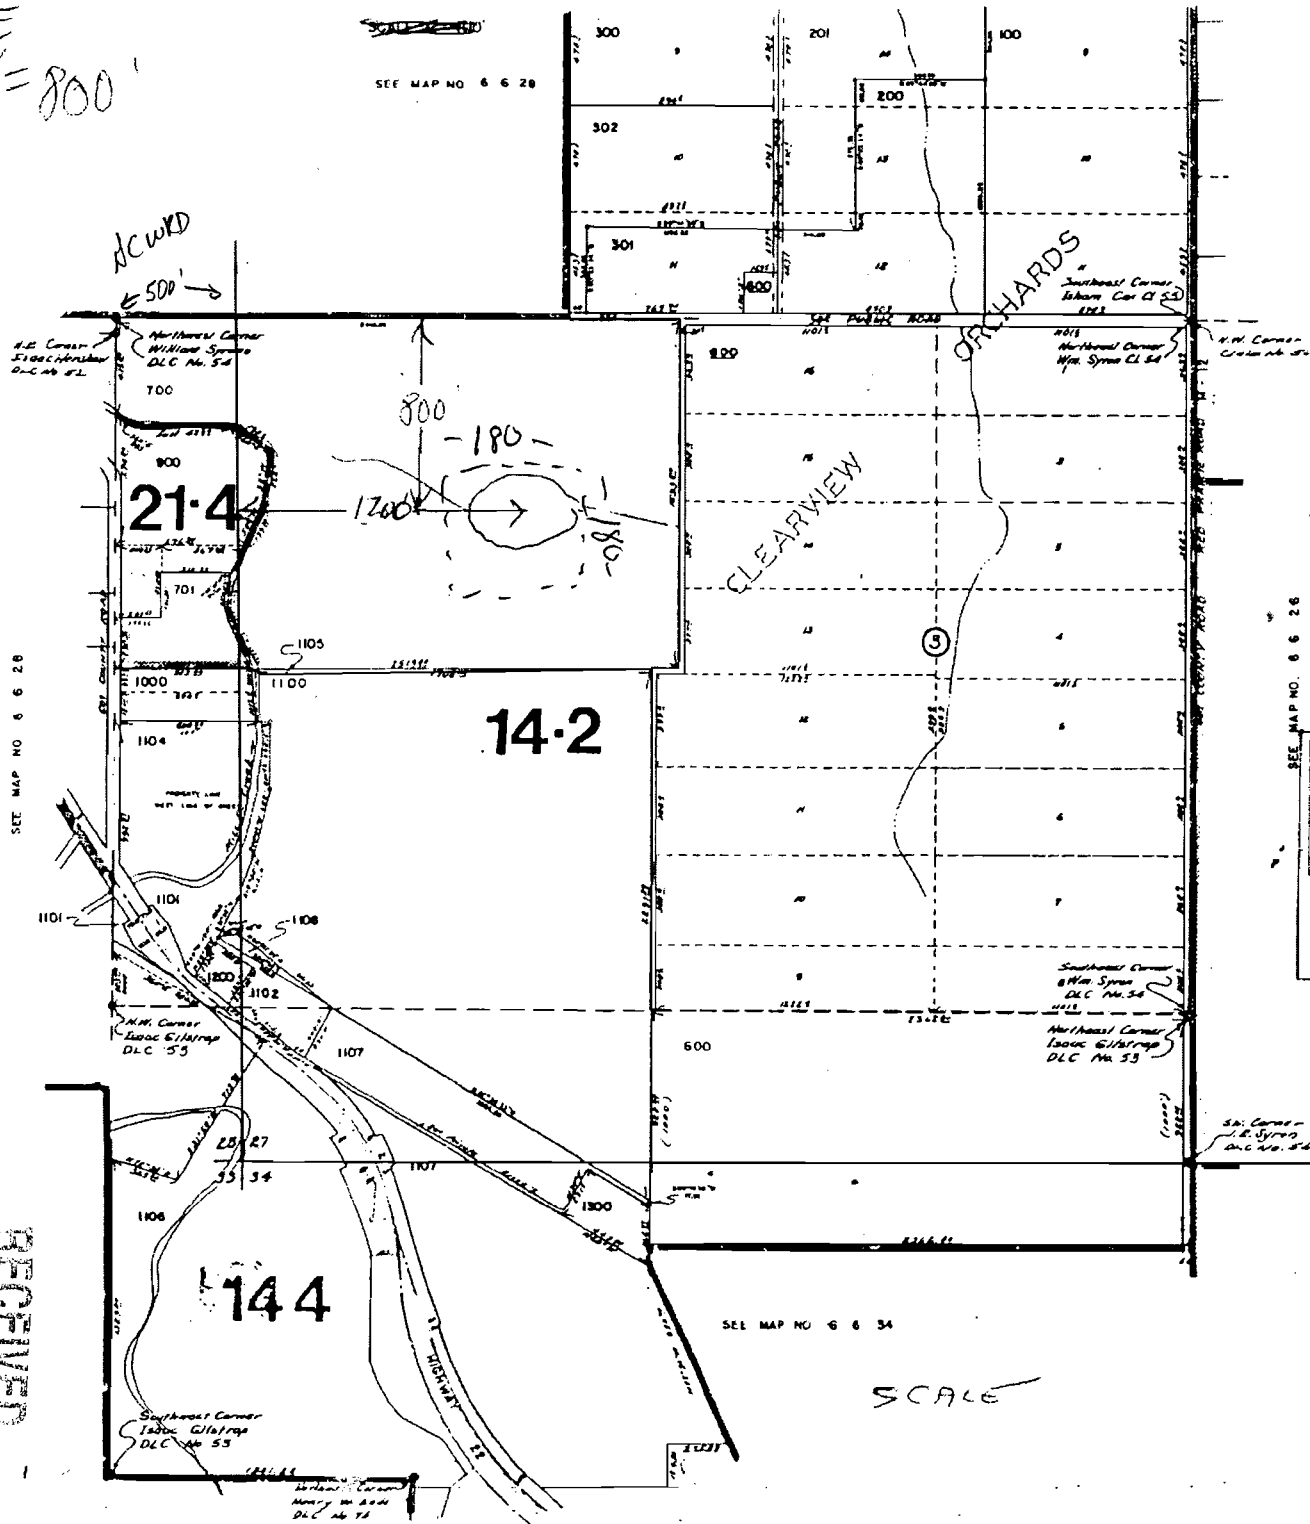

EAD NUMBERS  
 T.L. 601  
 T.L. 400  
 T.L. 500  
 T.L. 1103  
 T.L. 1400

SEE MAP NO. 6 6 26

RECEIVED

MAR 19 2002

WATER RESOURCES DEPT  
SALEM, OR

Application No. R-85083  
 Permit No. R-13427

ALBON

RECEIVED

OCT 29 2010

WATER RESOURCES DEPT  
SALEM, OREGON

SEE MAP NO 6 6 34

SCALE