


T29S, R9W, WM

SCALE 1" = 400'

DOUGLAS COUNTY

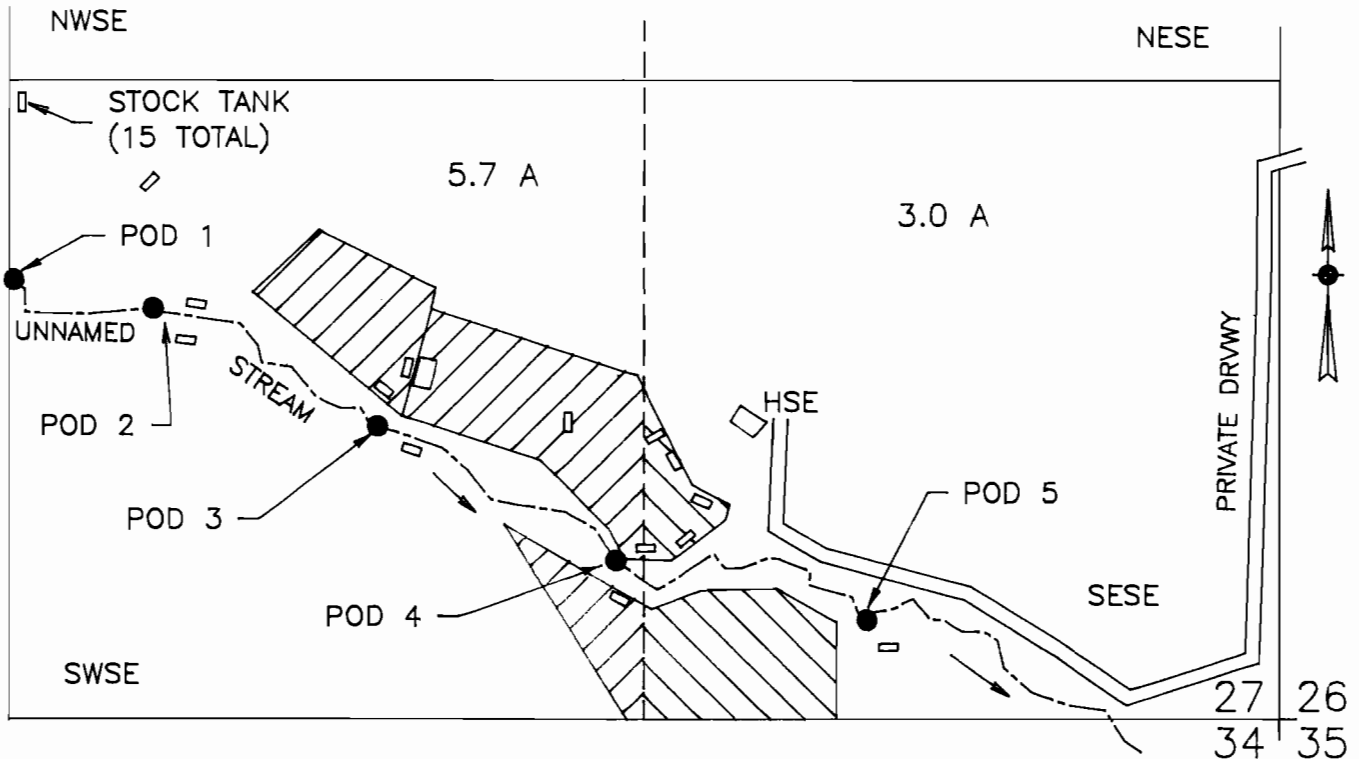

POD 1 IS 915 FT N AND 2625 FT W FROM SE COR SEC 27
POD 2 IS 855 FT N AND 2335 FT W FROM SE COR SEC 27
POD 3 IS 610 FT N AND 1870 FT W FROM SE COR SEC 27
POD 4 IS 330 FT N AND 1375 FT W FROM SE COR SEC 27
POD 5 IS 205 FT N AND 855 FT W FROM SE COR SEC 27

RECEIVED

SEP 08 1998

**WATER RESOURCES DEPT.
SALEM, OREGON**

FINAL PROOF SURVEY UNDER

Application No. S-70384 Permit No. 52838

IN NAME OF

GEORGE E OR JANICE E LANEY

Surveyed July 14, 1998 by M E Farr

MAURICE E FARR
395 NE KIRBY AVENUE
ROSEBURG, OR 97470

THIS IS A LOCATION MAP FOR A FINAL PROOF SURVEY BY
GEORGE E OR JANICE E LANEY. THIS MAP IS FOR THE
PURPOSE OF IDENTIFYING THE LOCATION OF THE WATER
RIGHT ONLY AND IS NOT INTENDED TO PROVIDE LEGAL
DIMENSIONS OR LOCATIONS OF PROPERTY OWNERSHIP LINES.

