

FINAL PROOF SURVEY FOR CHANGE IN POINT OF DIVERSION

IN THE NAME OF

GEORGE L. DAVIS, LARRY L. DAVIS,

GENEVA N. HOLMES

APPLICATION FILE NO. T.7736

SPECIAL ORDER VOLUME 51, PAGE 620

IN THE NW 1/4 OF THE SW 1/4

AND THE SW 1/4 OF THE NW 1/4

SECTION 24, T.11 S., R. 8 W., W.M.


LINCOLN COUNTY, OREGON

NOVEMBER 26, 1997

RECEIVED

MAR 17 1998

WATER RESOURCES DEPT
SALEM OREGON

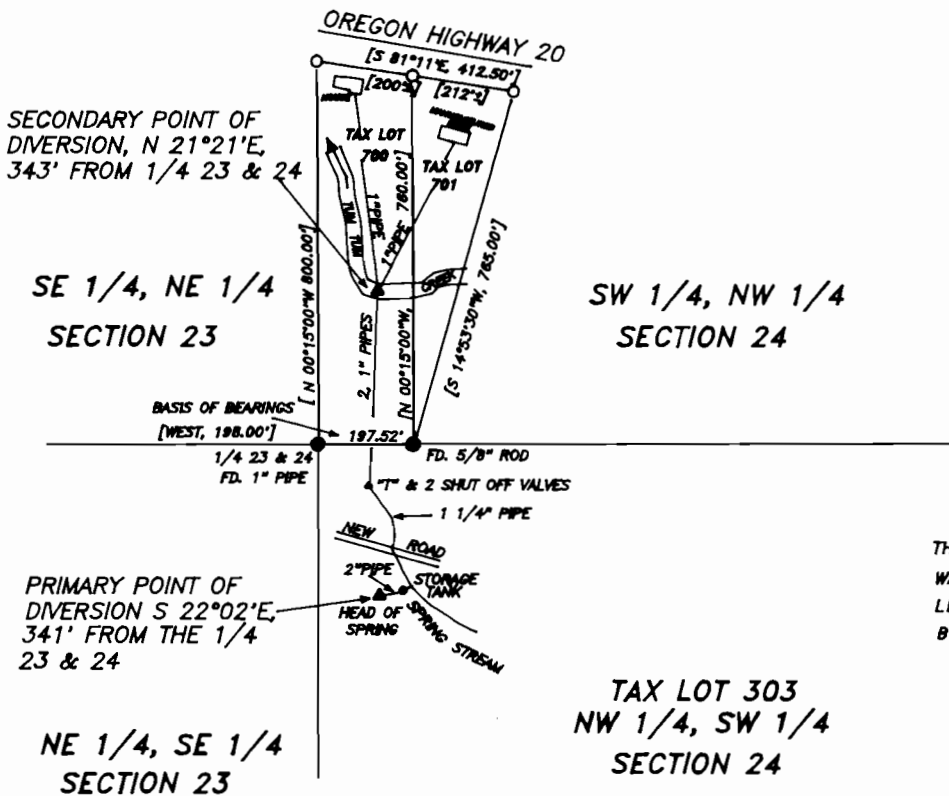

NARRATIVE

This map was generated using Application map No. 55709 and an Oregon State Highway map. Survey ties were made to the shown found corners, new diversion point, storage tank location, and the new road location. Ties were also made from the property corners along Highway 20 to the house, the manufactured home, and to Tum Tum Creek. The location of the creek was adjusted to show the present location.

THIS MAP IS FOR THE PURPOSE OF OBTAINING A WATER RIGHT AND IS NOT INTENDED TO PROVIDE LEGAL DIMENSIONS FOR LOCATIONS OF PROPERTY BOUNDARIES.

LEGEND

- ▲ DIVERSION POINT
 - CORNER FOUND AND TIED
 - CORNER PROJECTED FROM APPLICATION MAP
 - [] RECORD DATA
- SCALE 1 INCH = 400 FEET

SURVEYED BY:

L. W. HUNNEMULLER
3055 N. E. LANCASTER
CORVALLIS, OR 97330
PHONE: (541) 757-7614

