
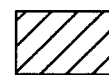


FINAL PROOF SURVEY
FOR
ADDITIONAL POINT OF DIVERSION
TRANSFER 6861
PLUM CREEK TIMBERLANDS
76928 MOSBY CREEK RD
COTTAGE GROVE, OR 97424


BY
FORD & ASSOCIATES
PO BOX 22735
EUGENE, OR 97402
(541) 344-1852
SEPTEMBER 2, 1999
revised MAY 7, 2009

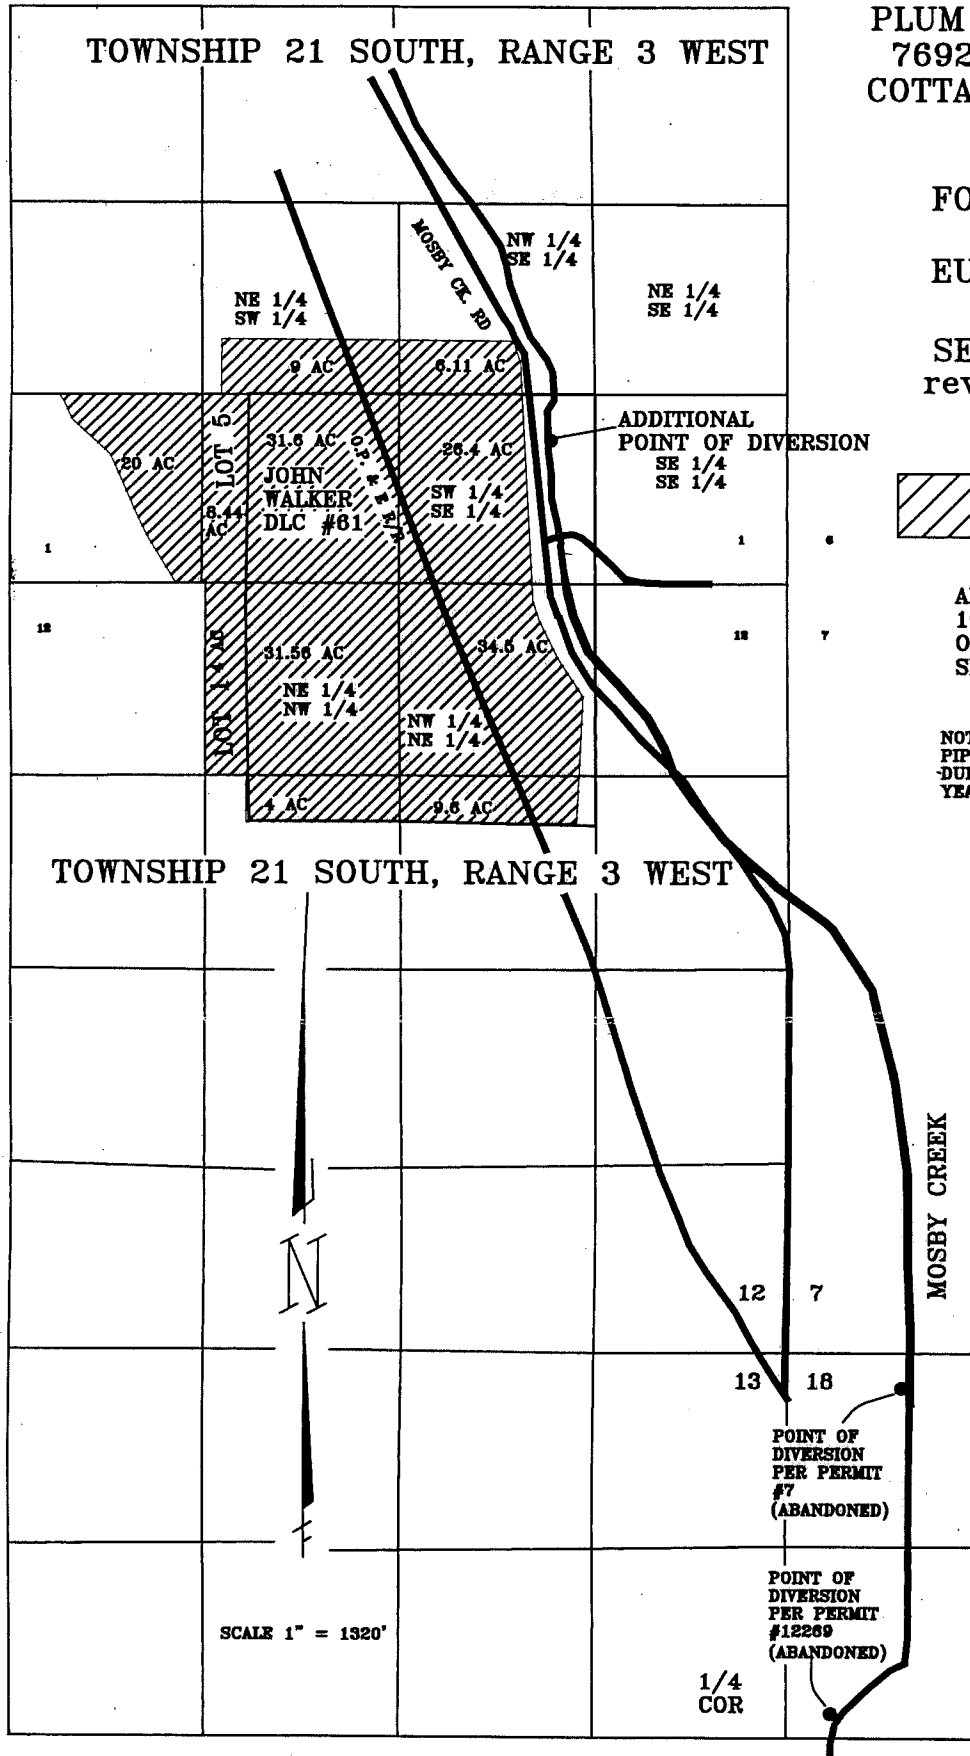

RIGHT PER PERMIT #7, 12269 & 23355
AREA BENEFICIAL USE FROM ADDITIONAL
POINT OF DIVERSION

ADDITIONAL DIVERSION LOCATION:
1015.12' NORTH & 1620.64' WEST
OF THE S.E. CORNER
SECTION 1.

NOTE:
PIPE IS NOT SHOWN ON MAP DUE TO BEING ABOVE GROUND
DURING IRRIGATION SEASON AND LOCATION VARIES FROM
YEAR TO YEAR.

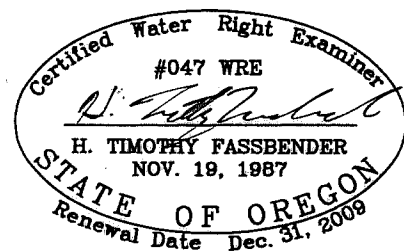

NOTE:
THIS MAP WAS PREPARED FOR THE
PURPOSE OF IDENTIFYING THE LOCATION
OF THE WATER RIGHT ONLY. IT IS
NOT INTENDED TO PROVIDE DIMENSIONS
OR LOCATION OF PROPERTY OWNERSHIP
LINES.

JOB NO. 2792
DWG NO. W2792F

AREAS IRRIGATED PER PERMIT #7 & QUANTITIES OF WATER USED PER 1/4

SECTION 12
NE 1/4 NW 1/4 = 31.56AC USING 0.47 CFS
SE 1/4 NW 1/4 = 4 AC USING 0.06 CFS
AREAS IRRIGATED PER PERMIT # 12269
SECTION 1
NE 1/4 SW 1/4 = 9 AC USING 0.13 CFS
SW 1/4 SW 1/4 = 20 AC USING 0.30 CFS
GOV. LOT 5 = 8.4 AC USING 0.12 CFS
SE 1/4 SW 1/4 = 31.8 AC USING 0.47 CFS
SW 1/4 SE 1/4 = 26.4 AC USING 0.39 CFS
SECTION 12
NW 1/4 NE 1/4 = 34.5 AC USING 0.51 CFS
SW 1/4 NE 1/4 = 9.6 AC USING 0.14 CFS
GOV. LOT 1 = 4 AC USING 0.06 CFS
AREAS IRRIGATED PER PERMIT # 23355
SECTION 1
NW 1/4 SE 1/4 6.11 AC USING 0.086 CFS

PERMIT # 7 ALLOWED 3.29 CFS
PERMIT # 12269 ALLOWED 4.33 CFS
PERMIT # 23355 ALLOWED 0.086

RECEIVED

JUL 02 2009

WATER RESOURCES DEPT
SALEM, OREGON

COBU MAP #0440