T.38S., R.11E., W.M.

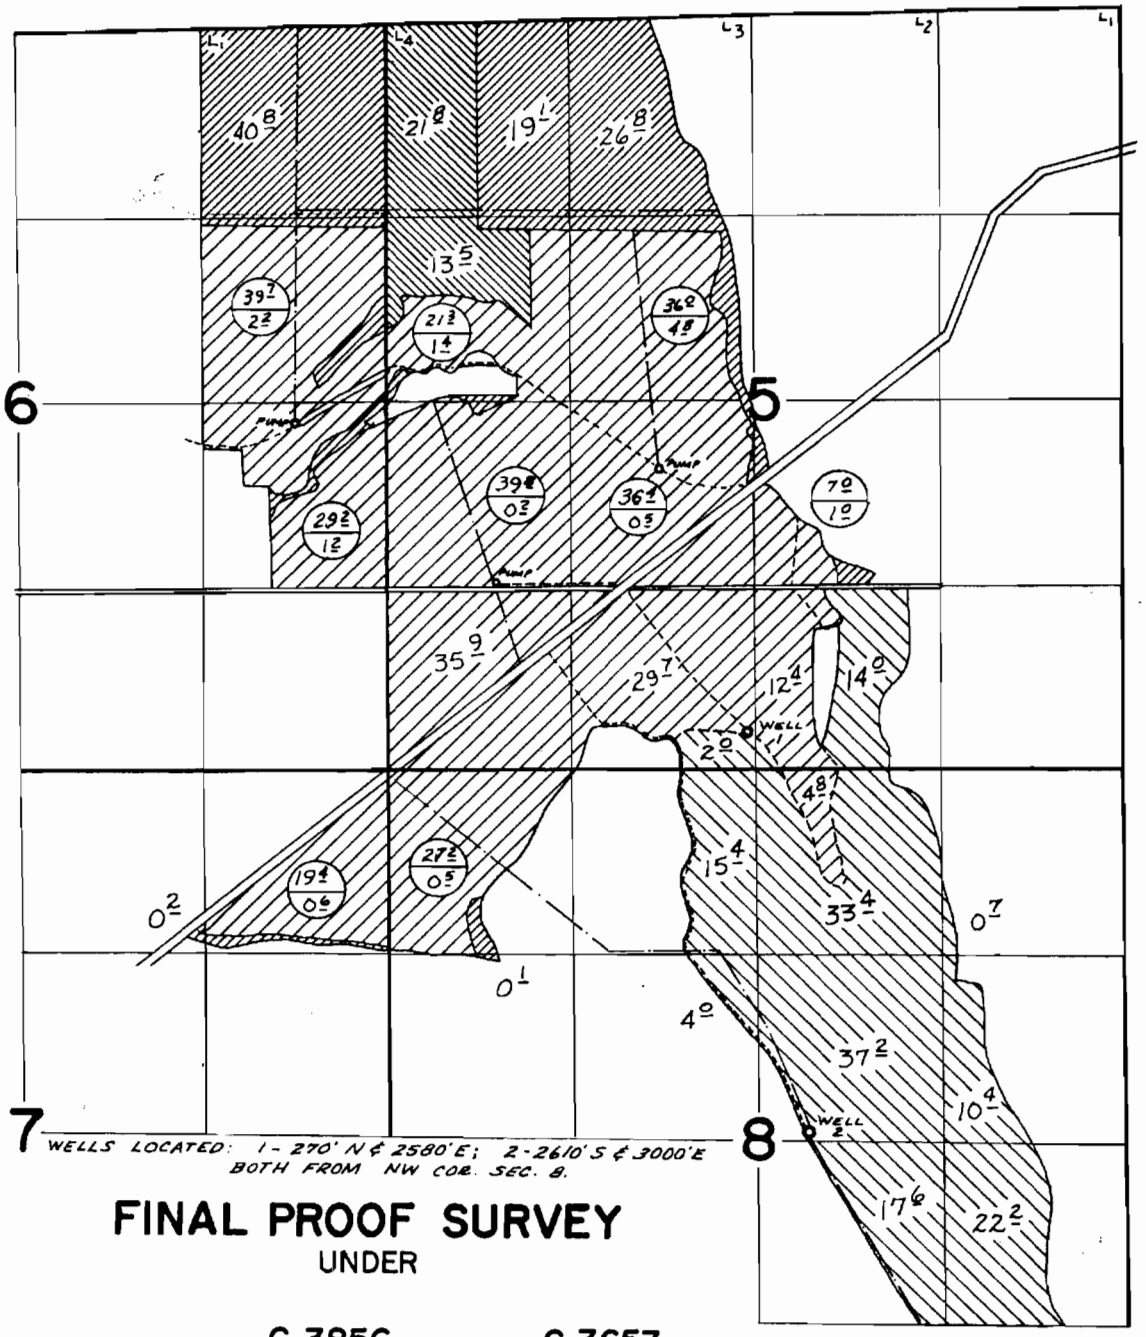

FINAL PROOF SURVEY

UNDER

Application No. G-3856 / G-4781 Permit No. G-3653 / G-4503

IN NAME OF
ESTATE OF LEONARD RITTER
AND JULIA RITTER

Surveyed Oct. 29 1974, by D.M.Norby

PRIMARY WELLS 1 & 2 PERMIT G-4503

SUPPLEMENTAL WELL 2 PERMIT G-3653

PRIMARY WELL 1 SUPPLEMENTAL WELL 2 PERMIT G-3653

PRIMARY WELL 2 PERMIT G-3653

SUPPLEMENTAL WELL 2

PRIMARY WELL 1

CNO-3JJ-182