


T. 7 N. R. 4 W. W.M.

NE 1/4 NE 1/4

SECTION 14

1" = 400'

HE 408

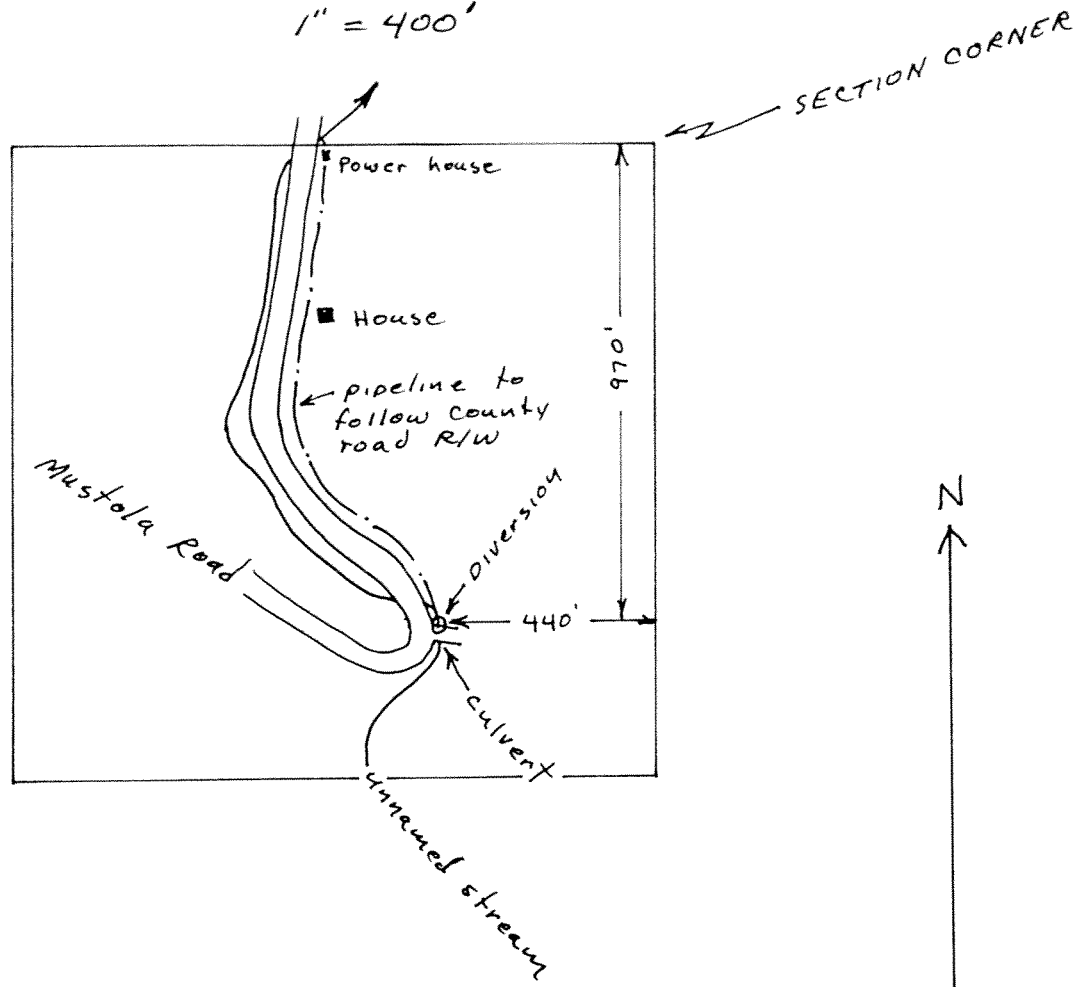

MICHAEL E. CLAWSON

RECEIVED

AUG 18 1982

WATER RESOURCES DEPT.
SALEM, OREGON

traced from applicants map.

SECTION 14 T.7N. R.4W. WM.

COLUMBIA COUNTY

THIS MAP HAS BEEN PREPARED FOR ASSESSMENT PURPOSES ONLY
Scale: 1" = 400' Current Revision Date: 3/19/99

