


T. 29S., R. 7W., W.M.

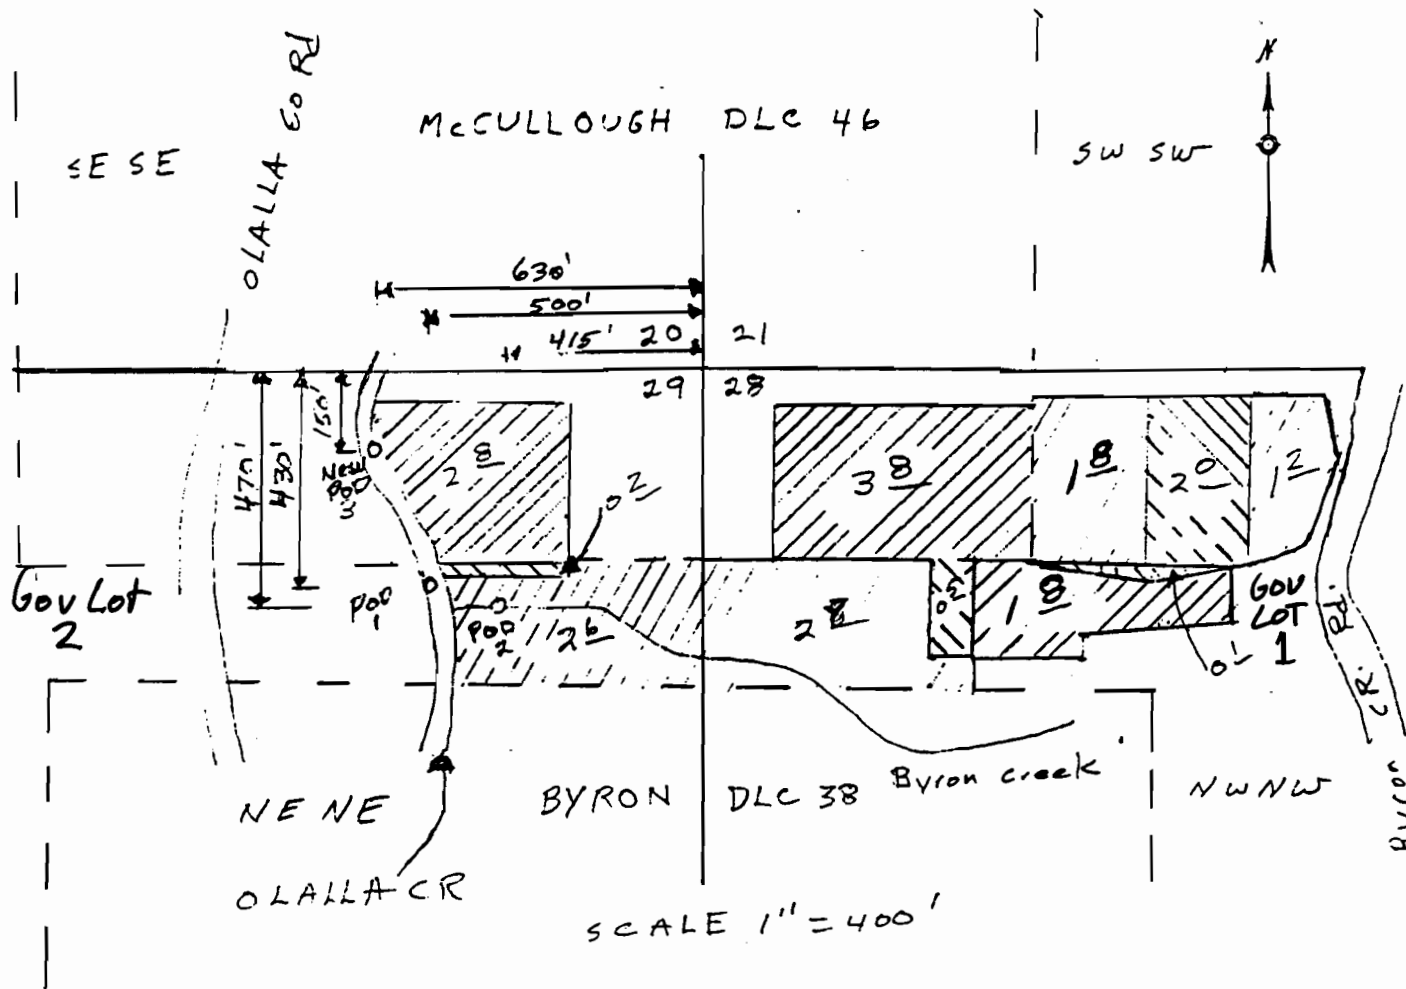


change TO
use & POD

change TO
POD

change FROM
PLACE OF USE

THE PURPOSE OF THIS MAP IS TO IDENTIFY THE LOCATION OF THE WATER RIGHT. IT IS NOT INTENDED TO PROVIDE INFORMATION RELATIVE TO THE LOCATION OF PROPERTY OWNERSHIP BOUNDARY LINES.

Scale: 1" = 400'

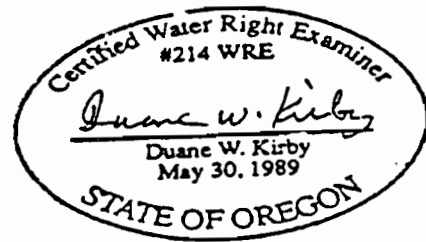

FINAL PROOF SURVEY UNDER

TRANSFER NO. 6613
IN NAME OF
GORDON L. HANEK
JOHN W. AND KATHERINE L. GRIFFEN
Surveyed JUNE...4... 19. 98 by DUANE KIRBY

Gov Lots added to map
by WRD 6/2/2001