



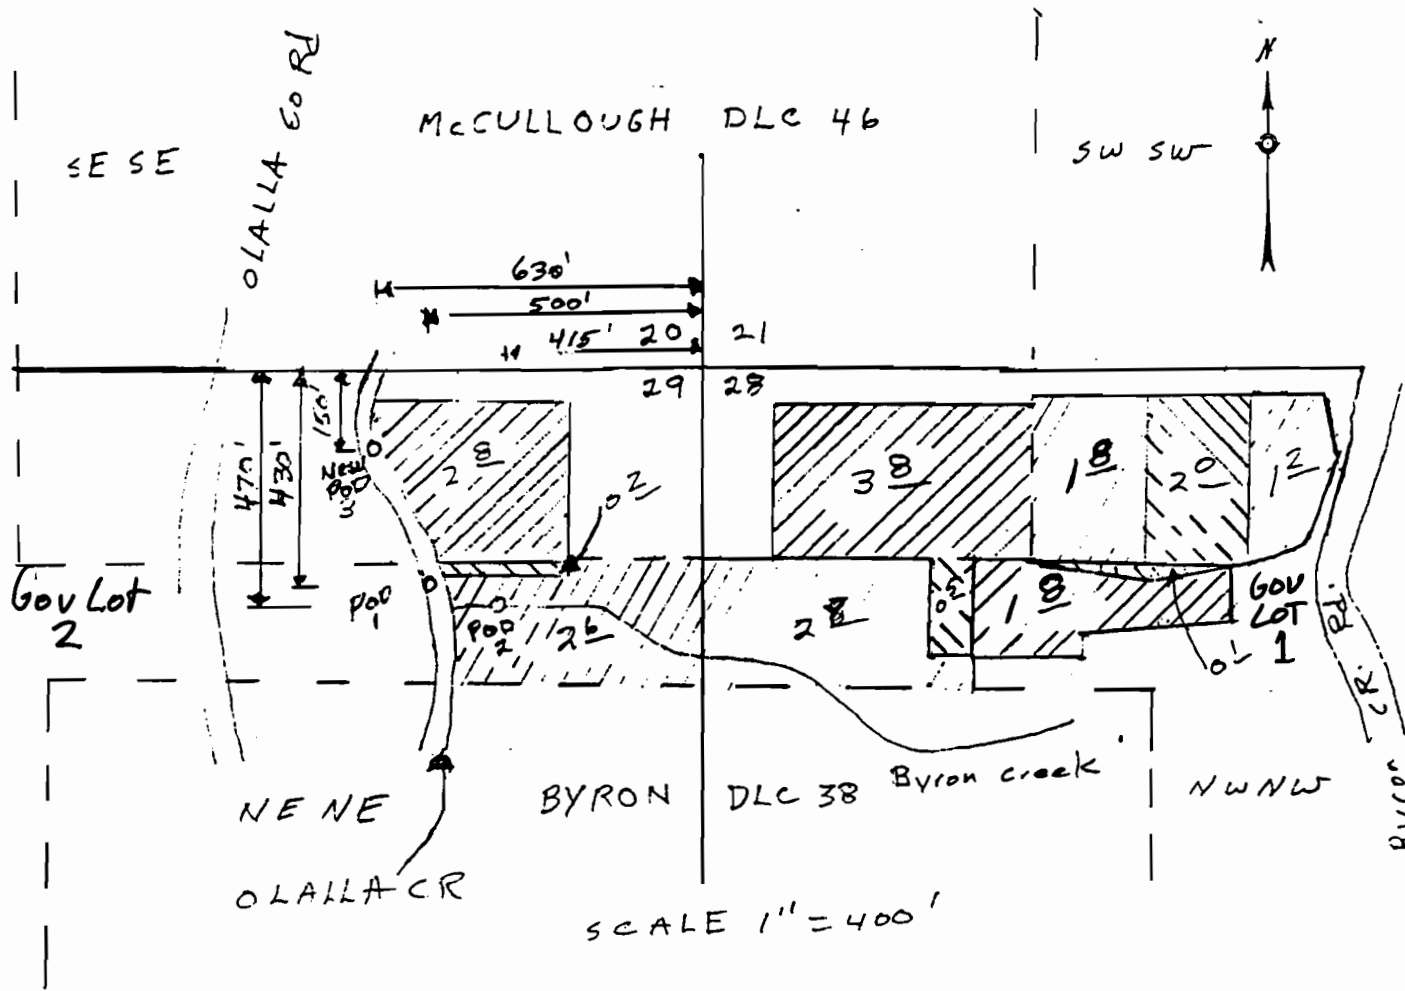

T. 29S., R. 7W., W.M.

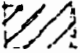

 change TO use & POD
 change TO POD
 change FROM place of use

THE PURPOSE OF THIS MAP IS TO IDENTIFY THE LOCATION OF THE WATER RIGHT. IT IS NOT INTENDED TO PROVIDE INFORMATION RELATIVE TO THE LOCATION OF PROPERTY OWNERSHIP BOUNDARY LINES.

Scale: 1" = 400'



FINAL PROOF SURVEY
UNDER

TRANSFER NO. 6613
 IN NAME OF
 GORDON L. HANEK
 JOHN W. AND KATHERINE L. GRIFFEN
 Surveyed JUNE...4... 19. 98 by DUANE KIRBY

Gov Lots added to map by WRD 6/2/2011