


T. 24 S., R. 8 W., W.M., Section 1

N

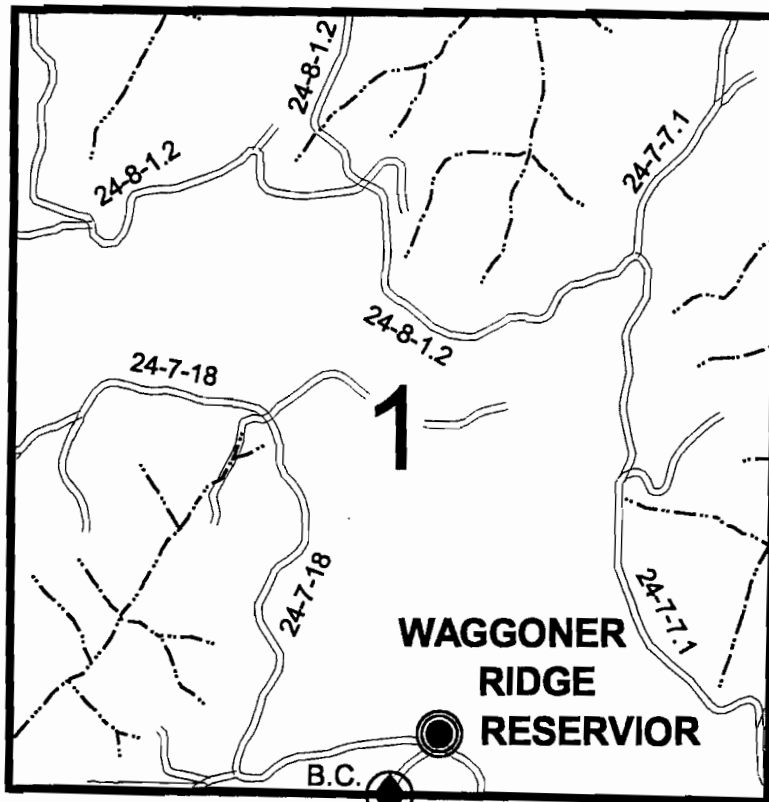

SCALE:
1" = 1320'



Diversion is:
420 ft. North and
338 ft East of the
S1/4 cor. Sec 1

CLAIM OF BENEFICIAL USE MAP

in name of

UNITED STATES BUREAU OF LAND MANAGEMENT

Application No.: R - 71507

S - 71508

RECEIVED


Permit No.: R - 12222

52779

SEP 25 2000

WATER RESOURCES DEPT.
SALEM, OREGON

SURVEYED: May 2, 2000

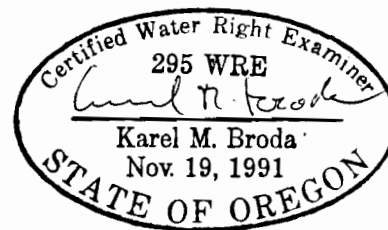

Expires: 12/31/01

THIS MAP WAS PREPARED FOR THE PUROSE OF IDENTIFYING THE LOCATION OF A WATER RIGHT ONLY
AND IS NOT INTENDED TO PROVIDE LEGAL DIMENSIONS OR LOCATION OF PROPERTY OWNERSHIP LINES.

U.S. Bureau of Land Management
Roseburg District Office
Division of Operations

Executed by:
Karel M. Broda, PE, CWRE
777 N.W. Garden Valley Blvd.
Roseburg, Oregon 97470