


T. 23 S., R. 6 W., W.M., Section 22

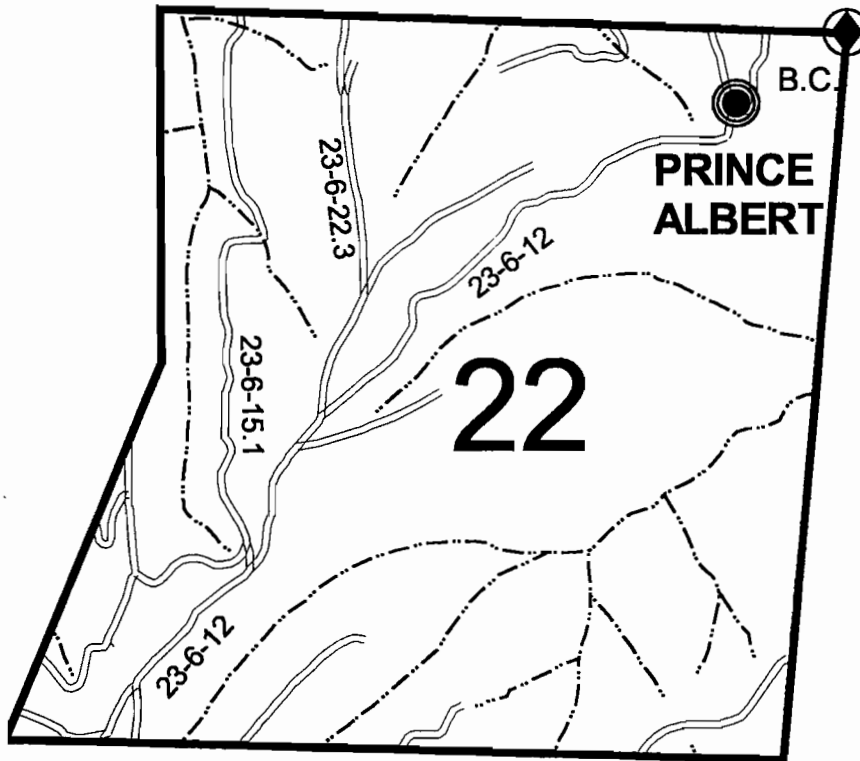

SCALE:
1" = 1320'



Diversion is:
479 ft. South and
768 ft. West of the
NE cor. Sec 22

CLAIM OF BENEFICIAL USE MAP

in name of

UNITED STATES BUREAU OF LAND MANAGEMENT

Application No.: R - 80592

S - 80591

Permit No.: R - 12011


52725

RECEIVED

SEP 25 2000

WATER RESOURCES DEPT.
SALEM, OREGON

SURVEYED: June 06, 2000

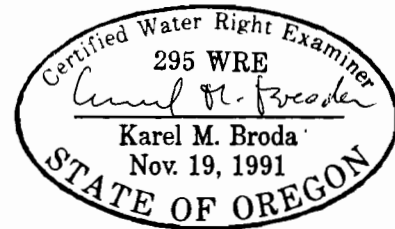

Expires: 12/31/01

THIS MAP WAS PREPARED FOR THE PURPOSE OF IDENTIFYING THE LOCATION OF A WATER RIGHT ONLY
AND IS NOT INTENDED TO PROVIDE LEGAL DIMENSIONS OR LOCATION OF PROPERTY OWNERSHIP LINES.

U.S. Bureau of Land Management
Roseburg District Office
Division of Operations

Executed by:
Karel M. Broda, PE, CWRE
777 N.W. Garden Valley Blvd.
Roseburg, Oregon 97470