

CLAIM OF BENEFICIAL USE MAP
 APPLICATION 58551, PERMIT 44330
 NW1/4NW1/4, SEC. 19, T.34S., R.2W., W.M.
 JACKSON COUNTY, OREGON
 FOR
 ROBERT AND GAYLE BORST
 14748 S.E. 185TH PLACE
 RENTON, WA 98058


RECEIVED

AUG 31 2011

WATER RIGHTS DEPT
 SALEM, OREGON



Scale: 1"=400'
 Date: August 8, 2011

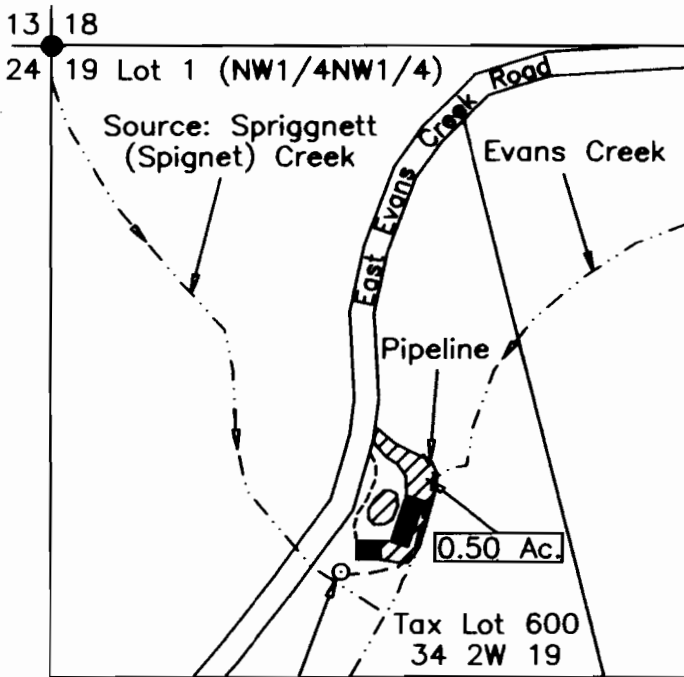


LEGEND

- Found Survey Monument
- Denotes Building
- Denotes Gravel Driveway
- - - - Denotes Pipeline - Location Approximate
- ▨ Denotes Area Under Permit No. 44330. Priority Date April 19, 1979

Point of Diversion
 No. 1

Point of Diversion No. 1 - Situated South 1100 feet and East 600 feet from Northwest Corner Section 19.
 42°36'15.9" North Latitude
 122°59'32.4" West Longitude
 WGS-84 Datum

This map was prepared for the purpose of identifying the location of a water right only and is not intended to provide legal dimensions or location of property ownership.

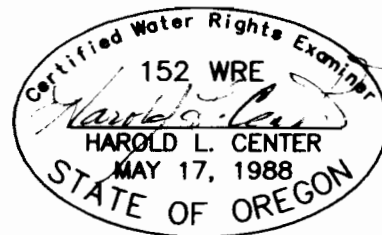

HAROLD L. CENTER
 2604 David Lane
 Medford, OR. 97504
 Phone 541-535-6108
 Oregon Certificate No. 152
 Cert. Renewal Date: 12/31/2011