

Township 9. S. Range 27. E. W. M.
Grant Co. Oregon.

SEC. 3


P-8269

3724

10/6c

By.

W. J. and Sarah E. Gollyhorn,
of
Monument, Oregon.

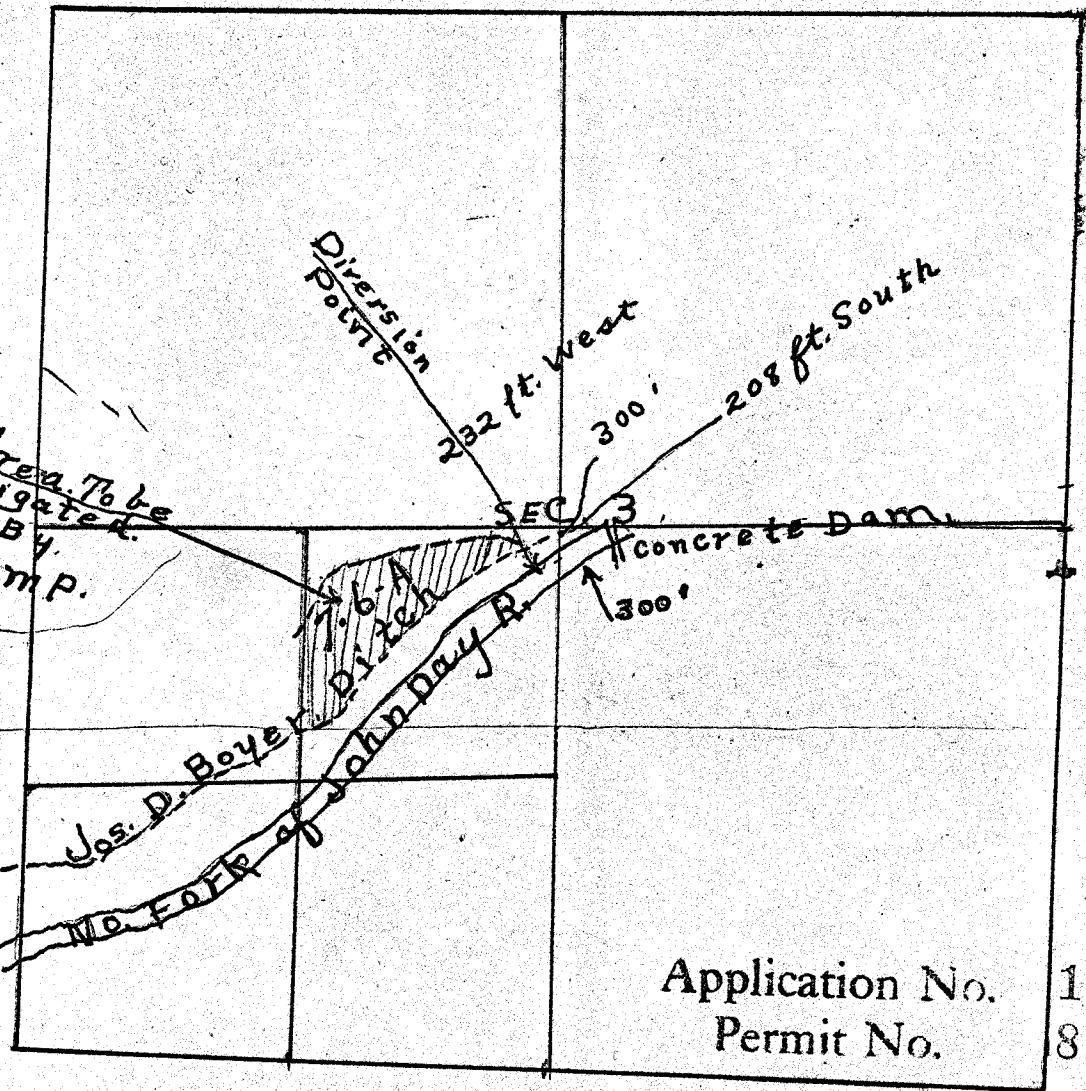

Application No. 11887
Permit No. 8269

CERTIFIED. 12/23-1927,
P. H. JUSTICE, ENGINEER,
NEW MEXICO LICENSE