


T.4S., R.1E., W.M.

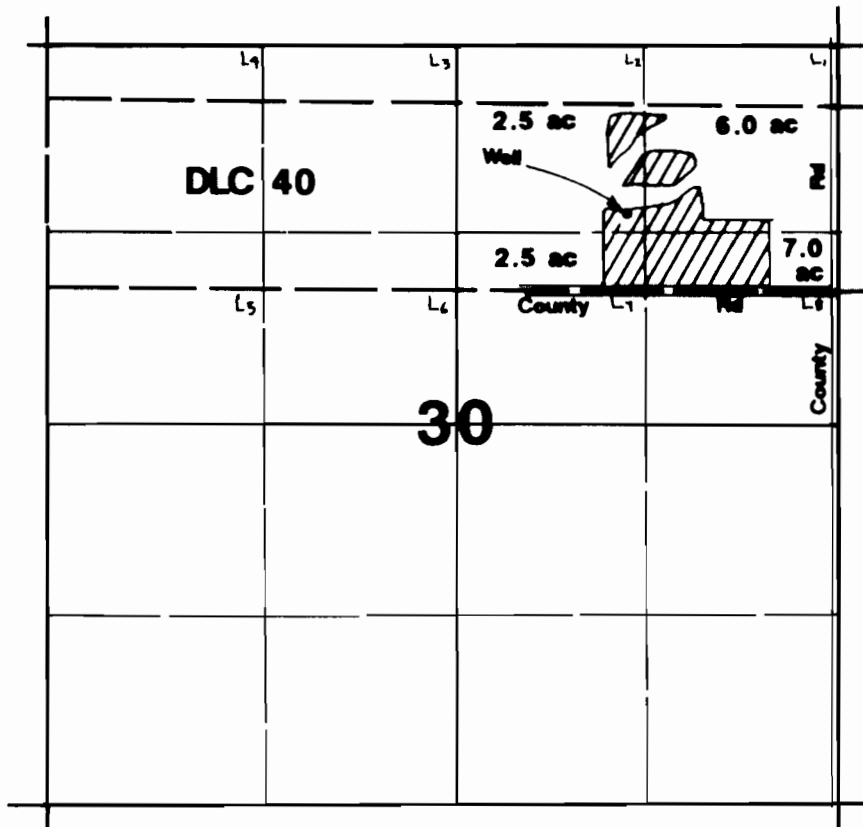

Well located 1150'S & 1450'W from NE corner Section 30.

Final Proof Survey

Application #: G-12656

Permit #: G-11768

In Name Of

Peoples Nursery

Surveyed on July 21, 1986 by J.M. Schuette

RECEIVED

AUG 13 1986

WATER RESOURCES DEPT.
SALEM, OREGON

THIS MAP WAS PREPARED FOR THE PURPOSE OF IDENTIFYING THE LOCATION OF A WATER RIGHT ONLY AND IS NOT INTENDED TO PROVIDE LEGAL DIMENSIONS OR LOCATION OF PROPERTY OWNERSHIP LINES.

