

T4N R1W, T4N R2W, T5N R1W, T5N R2W, W.M.
COLUMBIA COUNTY, OREGON

RECEIVED

JUN 30 2009

WATER RESOURCES DEPT
SALEM, OREGON

PREPARATION OF THIS MAP IS
FOR THE PURPOSE OF
IDENTIFYING THE LOCATION OF
THE WATER RIGHT ONLY. THERE
IS NO INTENT TO PROVIDE
DIMENSIONS OR LOCATION OF
PROPERTY OWNERSHIP LINES.

SURVEY MAP

AND CLAIM OF BENEFICIAL USE UNDER


Application No. G-13717, Permit No. G-12834

In The Name Of
the McNulty Water PUD
for

Quasi-Municipal Use
from a well (Stone Road #2) in the McNulty Basin
Surveyed November 21, 2008
by John E. Borden, CWRE

SCALE: 2" = 1 MILE

NOTE:
WELL LOCATION (P.O.A.) IS
359 feet North and
751 feet West from the
Cen 1/4 Cor Sec 13,
T4N, R1W, W.M.
2-8-09
9/23/2011

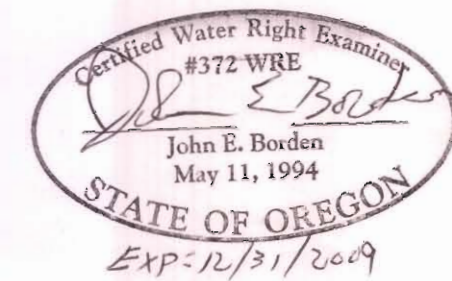

LEGEND

- P.O.U. PERMITTED
- P.O.U. BOUNDARY CLAIMED
- USGS GRID
- ROADWAY
- RAILWAY
- POWER LINE
- OPEN WATER
- WATER DISTRIBUTION
- SECTION CORNER
- 1/4 CORNER
- 1/4-1/4 CORNER
- WELL
- GATE VALVE
- PRESSURE REDUCTION VALVE
- FIRE HYDRANT
- RESERVOIR

JOHN BORDEN
CONSULTING

5597 RIVER STREET
503-723-4257
WEST LINN, OR. 97068

IN THE SECTIONS SHOWN OF
T4NR1W, T4NR2W, T5NR1W, T5NR2W, W.M.
COLUMBIA COUNTY, OREGON.

SURVEYED FOR: MCNULTY WATER PUD

SURVEYED BY: JOHN E. BORDEN

11/21/08

SCALE: 2" = 1 MILE

DRAWN: CRW

03/10/09

FILEPATH & NAME: E:/STONE WELL/Stone Well_051509.dwg

COBU MAP # 0439