

THIS MAP WAS PREPARED FOR THE PURPOSE OF IDENTIFYING THE LOCATION OF A WATER RIGHT ONLY AND IS NOT INTENDED TO PROVIDE LEGAL DIMENSIONS OR LOCATION OF PROPERTY OWNERSHIP LINES.

MAP IS BASED ON ASSESSORS MAPS OF T3S R3W SECTION 23 AND A 2010 AERIAL PHOTO RECEIVED FROM GOOGLE EARTH.

CLAIM OF BENEFICIAL USE MAP

APPLICATION G-15468 / PERMIT G-15236

LOCATED IN THE HARVEY CREEK BASIN

IN SECTION 23 AND 26 T3S R3W W.M., YAMHILL COUNTY, OREGON

LOTS 2302, 2303, 2304, 2305 AND 2306 OF TAX MAP T3N R3W SECTION 23

FOR:
LAUGHLIN - RED HILL, LLC
 MEMBERS: RONNI LACROUTE AND
 BERNARD LACROUTE
 19143 NE LAUGHLIN ROAD
 YAMHILL, OREGON 97148


RECEIVED



MAR 16 2011

WATER RESOURCES DEPT
 SALEM, OREGON

Certified Water Right Examiner
59859
Kaid E. McKay
KAID EDWARD MCKAY
 MAY 21, 2010
STATE OF OREGON
 EXPIRES : 12-31-2012

⊗ WELL
 ⊙ METER

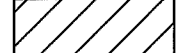 IRRIGATED AREAS PERMIT G-15236
 - · - · - EXISTING MAIN IRRIGATION PIPES
 ———— PROPERTY BOUNDARY LINE
 - - - - TAX LOT LINE
 - - - - 1/16TH SECTION LINE
 - - - - DLC LINE

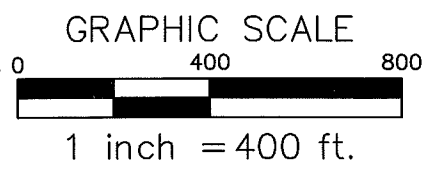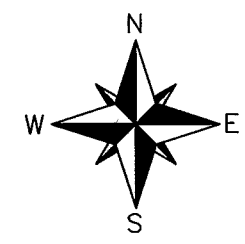

Project: 310-2-042
 By: Kaid E. McKay
 Checked by: Kaid E. McKay
 Date: March 7, 2011

