


UMATILLA COUNTY

FINAL PROOF SURVEY

for Transfer No. T-6310 and T-6412

in the name of
Phone No. 503-567-3521

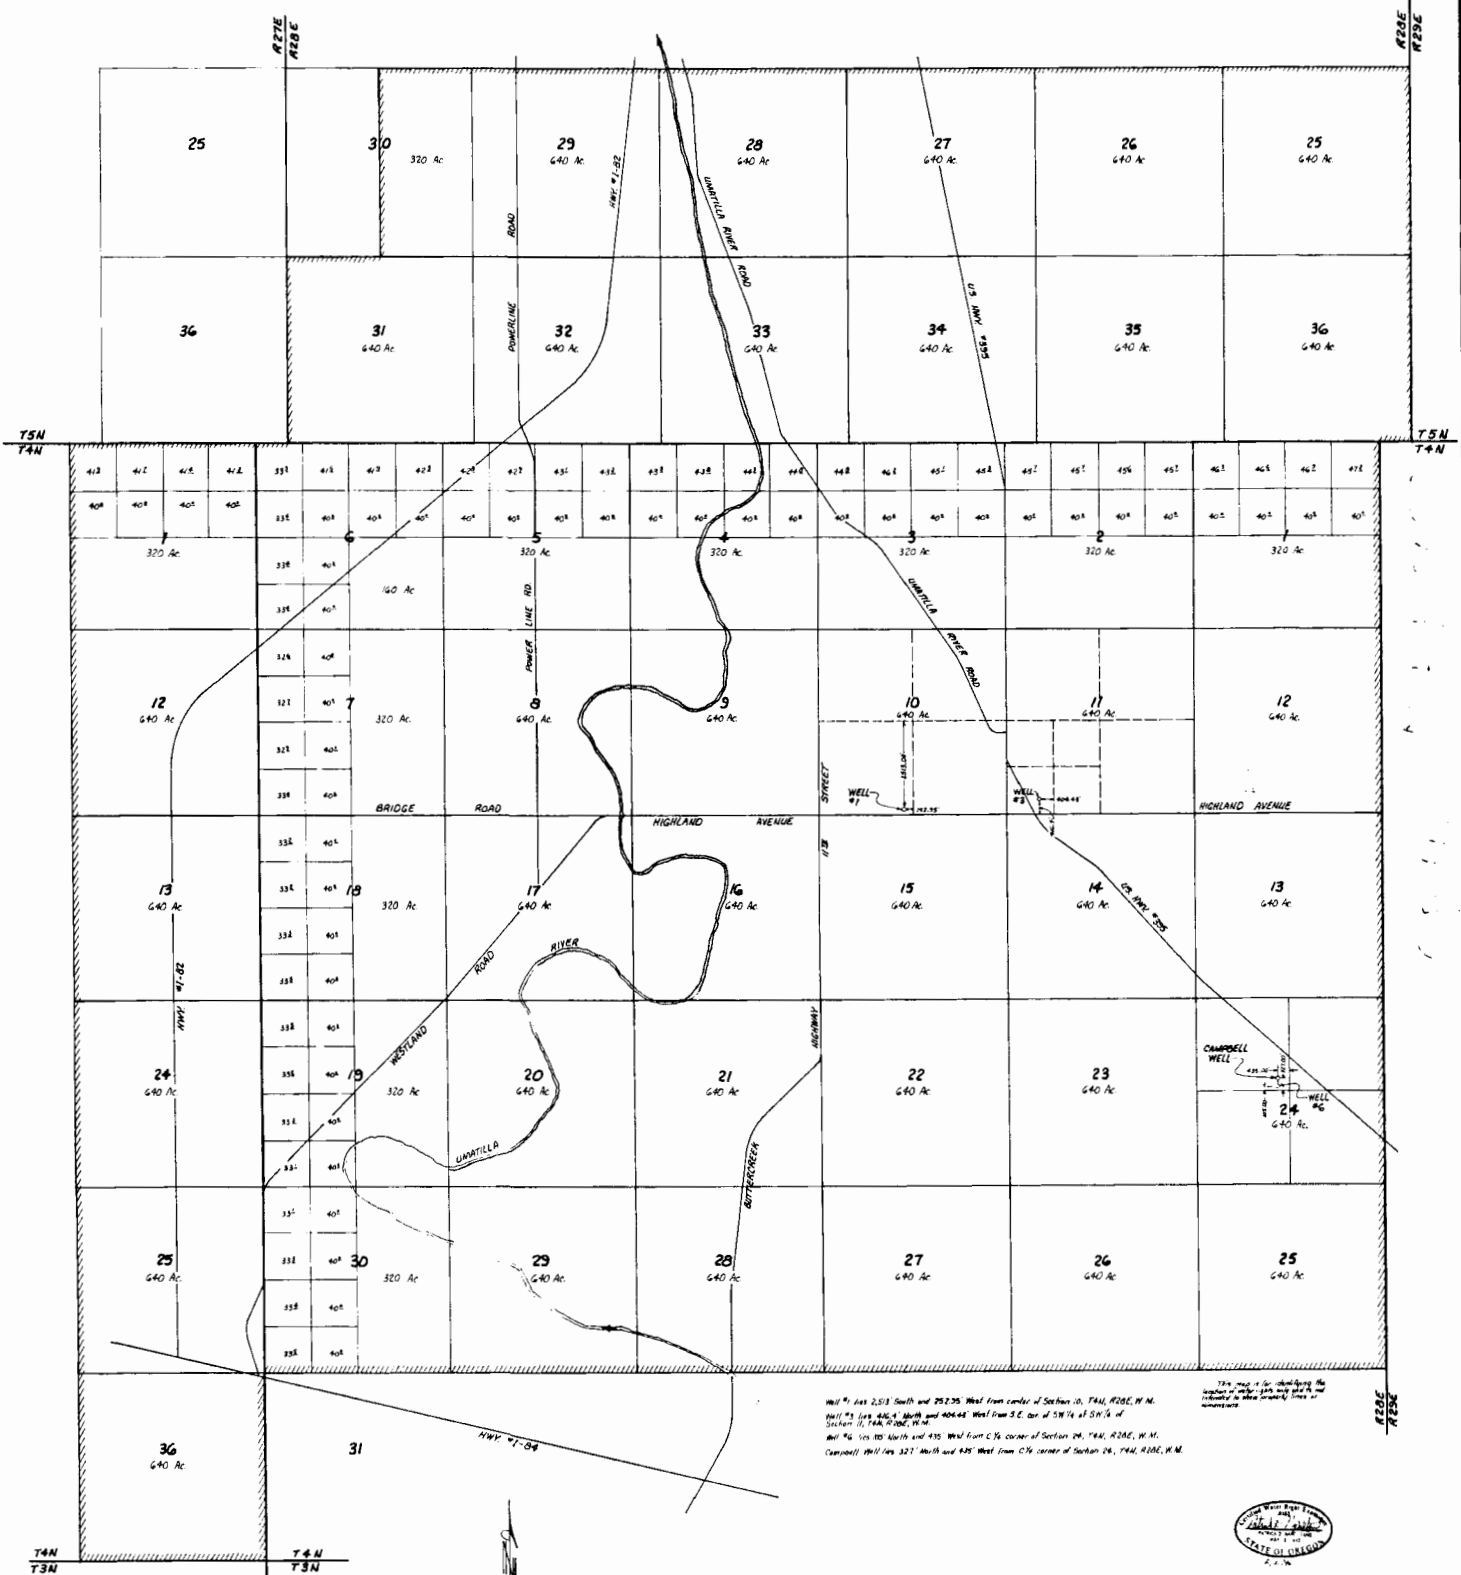





503-567-3335
7/4/95
DRAWN BY: S.A.G.

0028