


T5N, R28E, W.M., T4N, R28E, T4N, R27E, W.M.,  
UMATILLA COUNTY

**FINAL PROOF SURVEY**

for Tract No. T-6318 and T-642

IN THE NAME OF  
City of Hermiston  
100 N.E. 2nd Street  
Hermiston, OR 97130  
Phone No. 503-547-3521

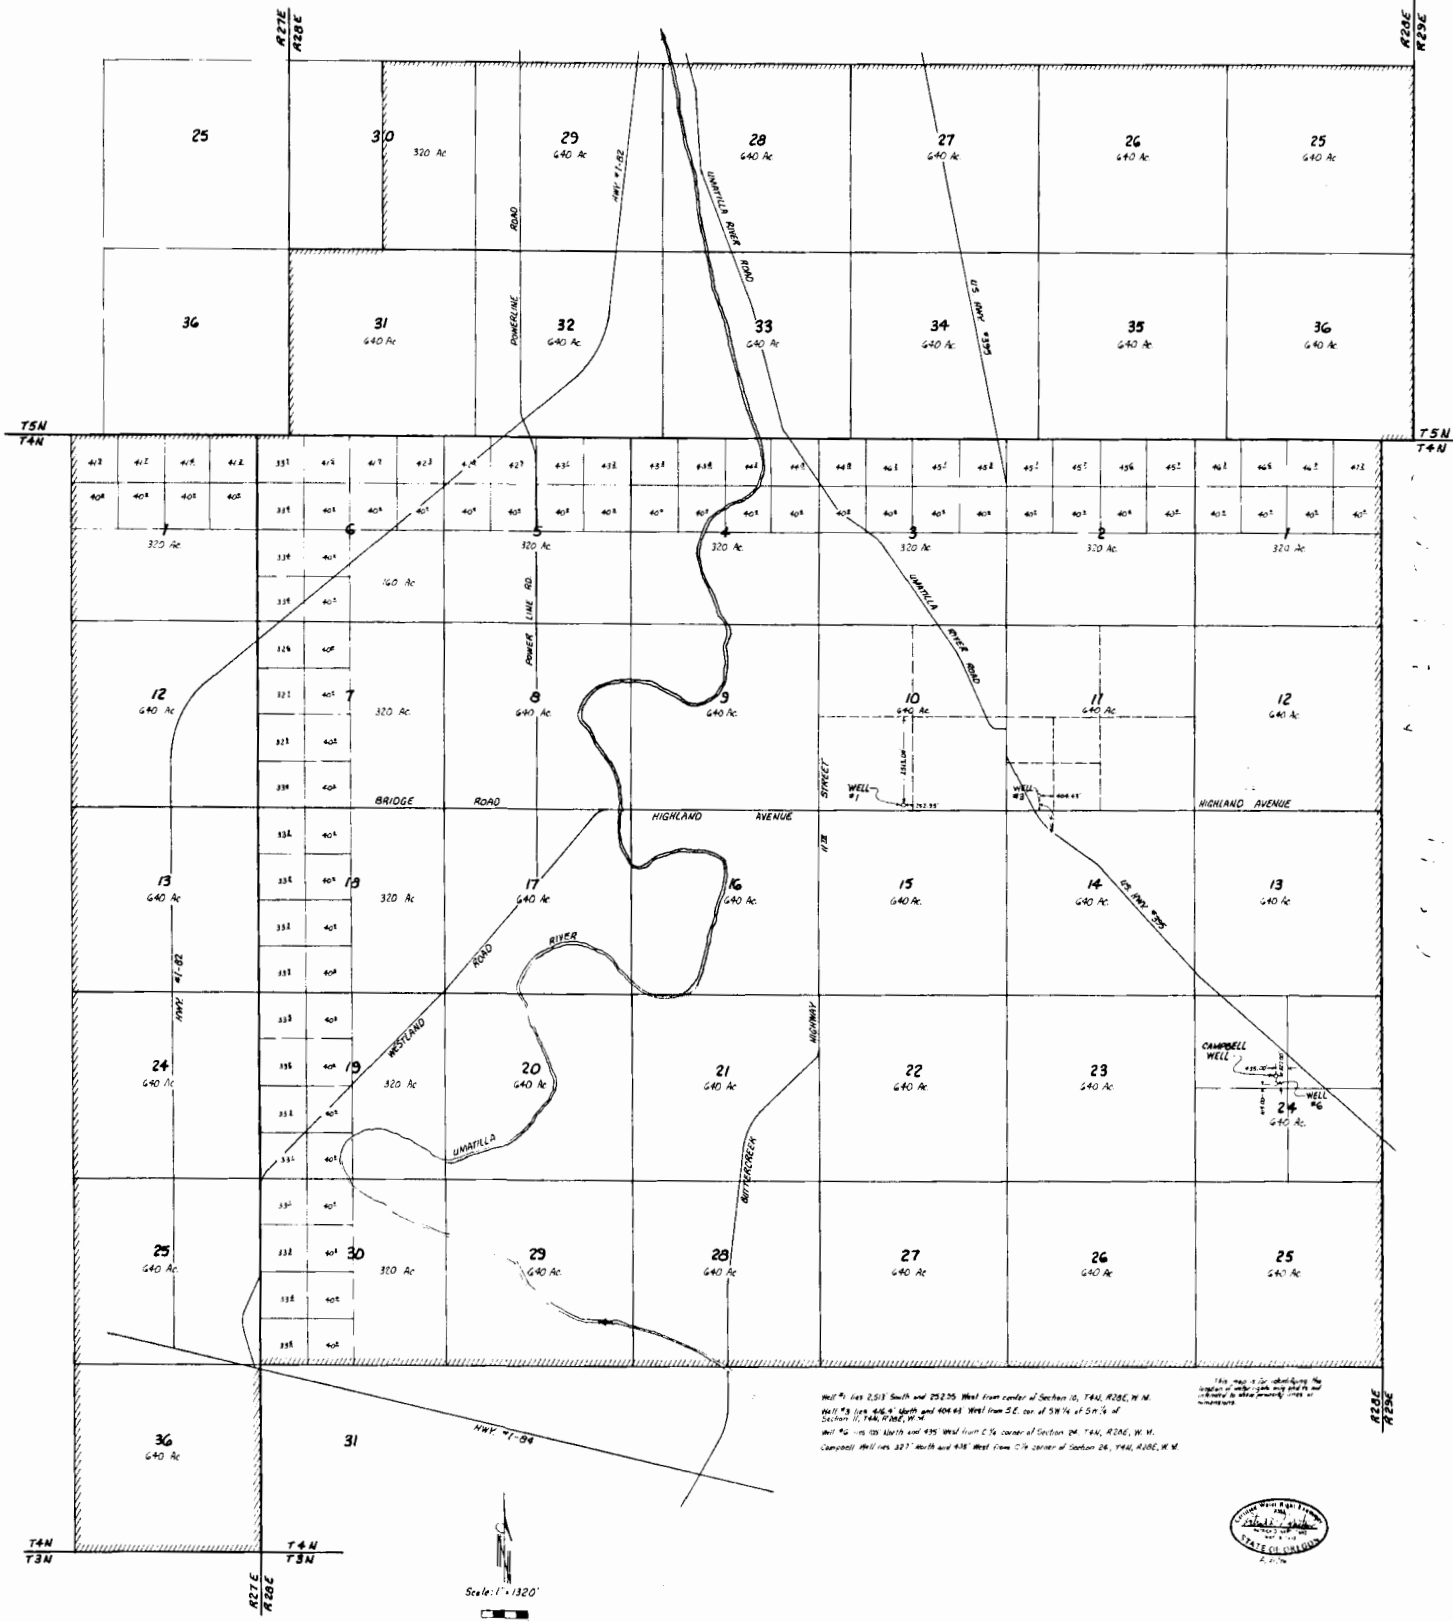





0028

CITY OF HERMISTON 100 N.E. 2nd Street  
 Hermiston, Oregon 97130  
 503-547-3335  
 1/6/95