


T5N, R28E, W.M., T4N, R28E, T4N, R27E, W.M.,  
UMATILLA COUNTY

**FINAL PROOF SURVEY**

for Tract No. T-6318 and T-642

IN THE NAME OF  

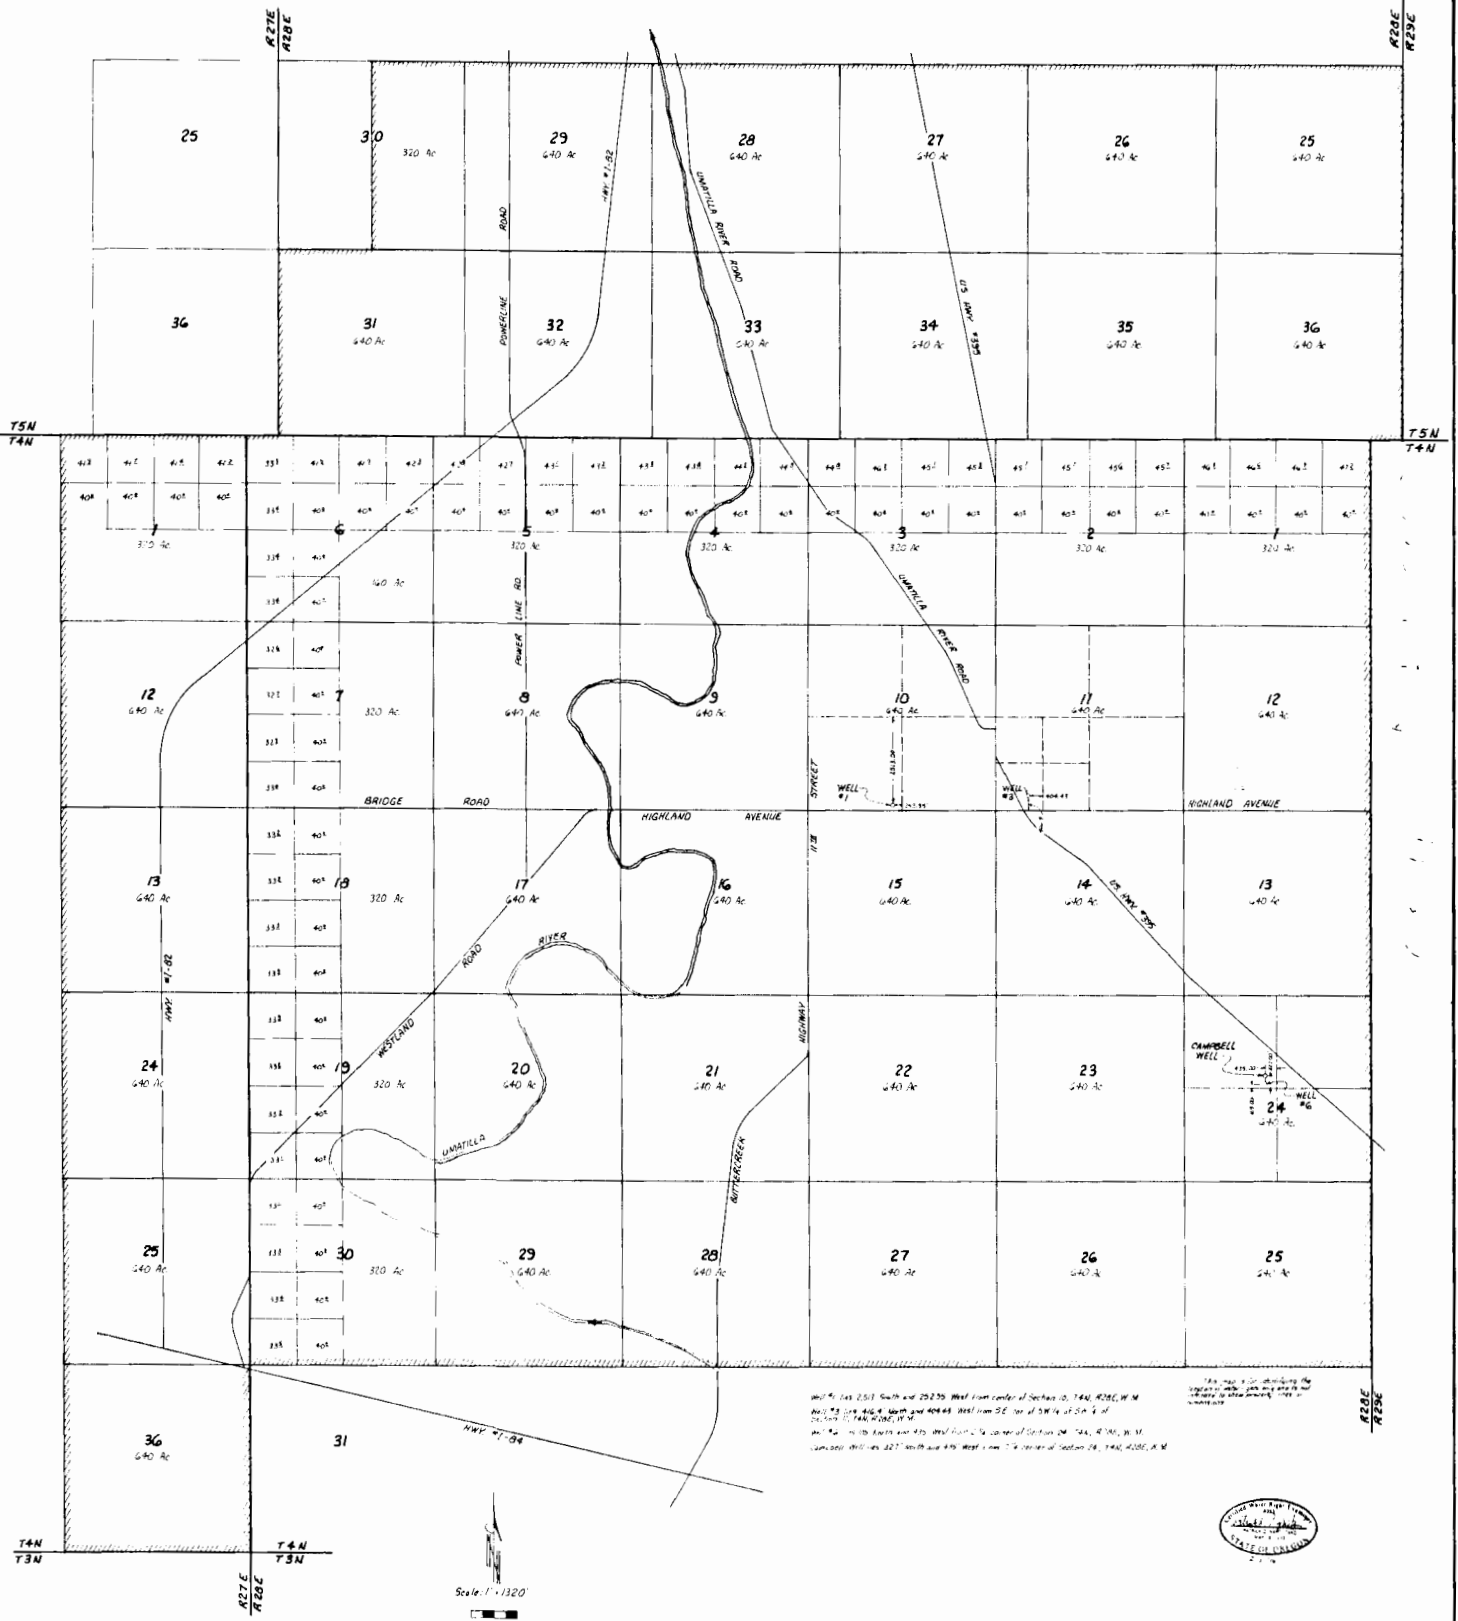

1/2 Sec. 24, 25, 26, 27, 28, 29, 30, 31, 32, 33, 34, 35, 36, T4N, R28E, W.M.  




0028