
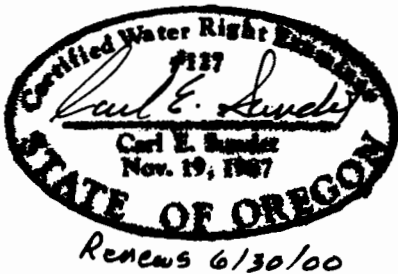
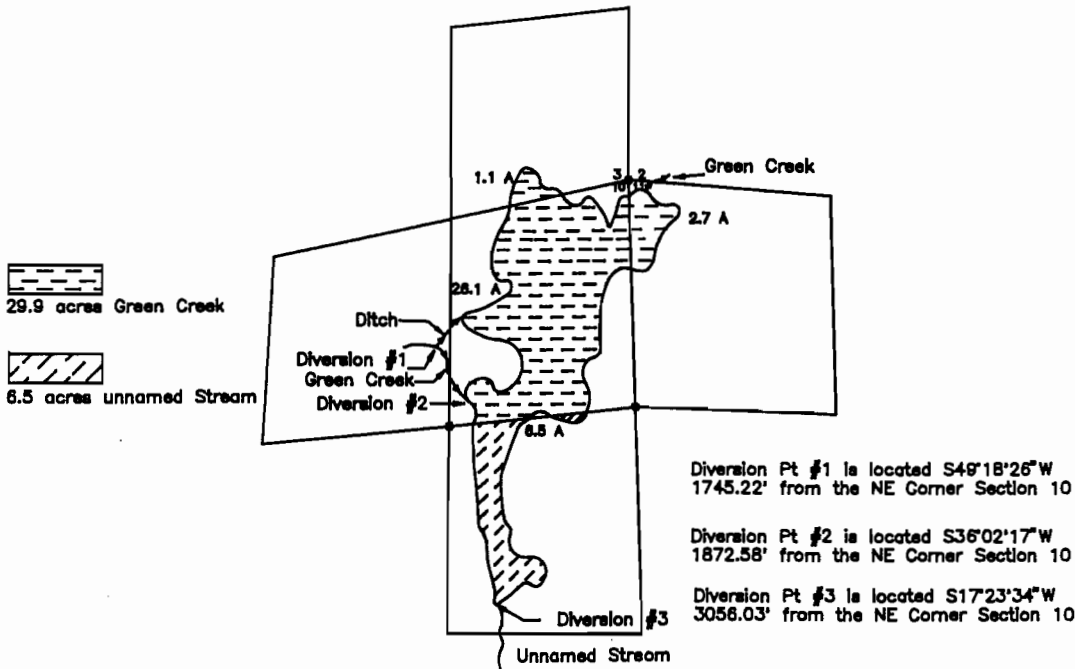


FINAL PROOF MAP
Sections 3, 10 & 11, T.36S. R.19E., W.M.
 Lake County, Oregon

RECEIVED

APR 8 1999
 WATER RESOURCES DIV.
 SALEM, OREGON

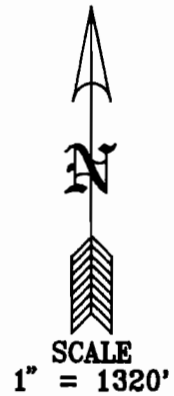

THIS MAP IS FOR THE PURPOSE OF IDENTIFYING THE LOCATION OF THE WATER RIGHT ONLY AND IS NOT INTENDED TO PROVIDE LEGAL DIMENSIONS OR PROPERTY LINE LOCATIONS.

Survey for: James R. & Mary Diane Elder
 Survey by: Sundet & Associates
 P.O. Box 1228
 Lakeview, OR 97630
 541-947-3293

Dr. eld-fpw

71353