


T5N, R36E, WM
SECTION 22
UMATILLA COUNTY

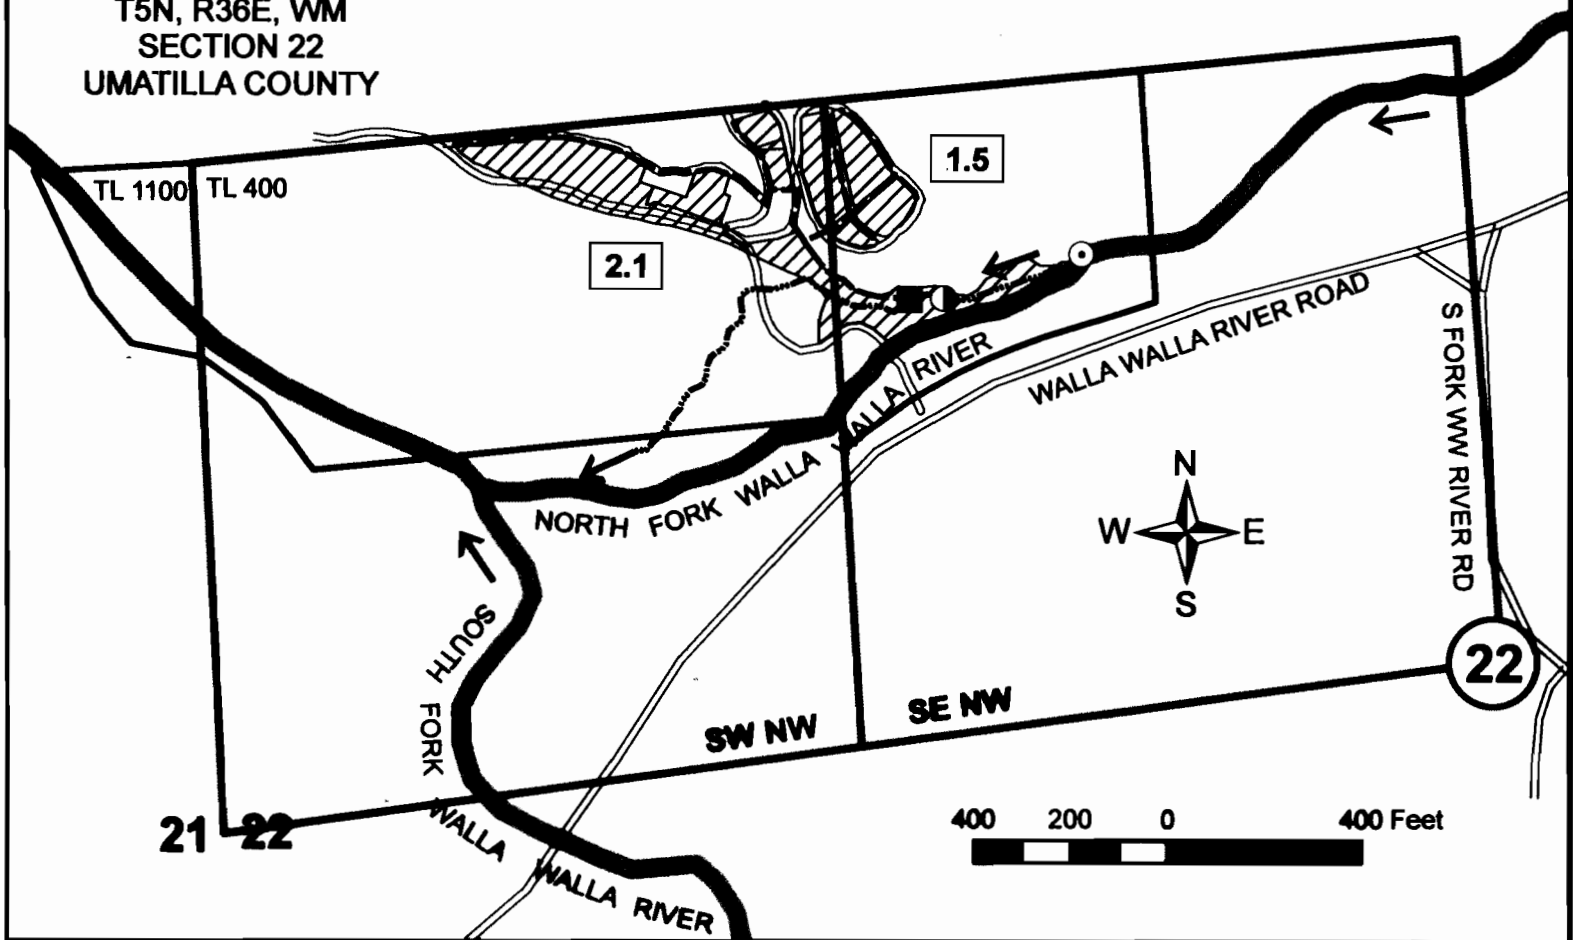

Point of Diversion

Gravity surface water diversion located in the SE/4 of NW/4 of Section 22 at a distance 940 feet N and 800 feet W from the Center of Section 22.



Flow Control Headgate

Flow control headgate located about 300 feet downstream of point of diversion. Excess flow returns to river.



Fish Screen

Fish screen located 75 feet downstream of flow control headgate. Flow measurement weir located at fish screen outlet. Pump station at same location diverts water from ditch immediately downstream of measurement weir. Excess flow returns to river.



Irrigation Ditch

Gravity ditch conveys water from point of diversion to pump station. Unused portion of diverted water returns to river.



Mainline


Pressurized mainline pipe conveys water from pump station to place of use.



Place of Use

Water beneficially used for irrigation of 3.6 acres:
2.1 acres in SW NW of Section 22
1.5 acres in SE NW of Section 22

The purpose of this map is to identify the location of a water right. It is not intended to provide information regarding the location of property ownership boundary lines.

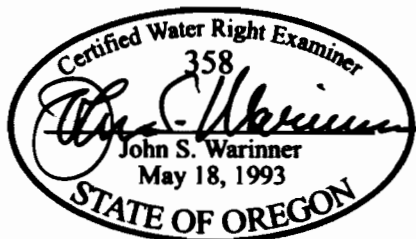

FOUNTAINHEAD
1204 Alvarado Terrace
Walla Walla, WA 99362
509.529.2646 phone

**CLAIM OF BENEFICIAL USE
Transfer 10418**

in the name of
CAYUSE VINEYARDS

Revised 22 JUN 2011