


↑  
N.

CORRECTED MAP FOR #  
RESERVOIR CERTIFICATE R-72068  
9-14-09  
(MAP NOT TO SCALE)

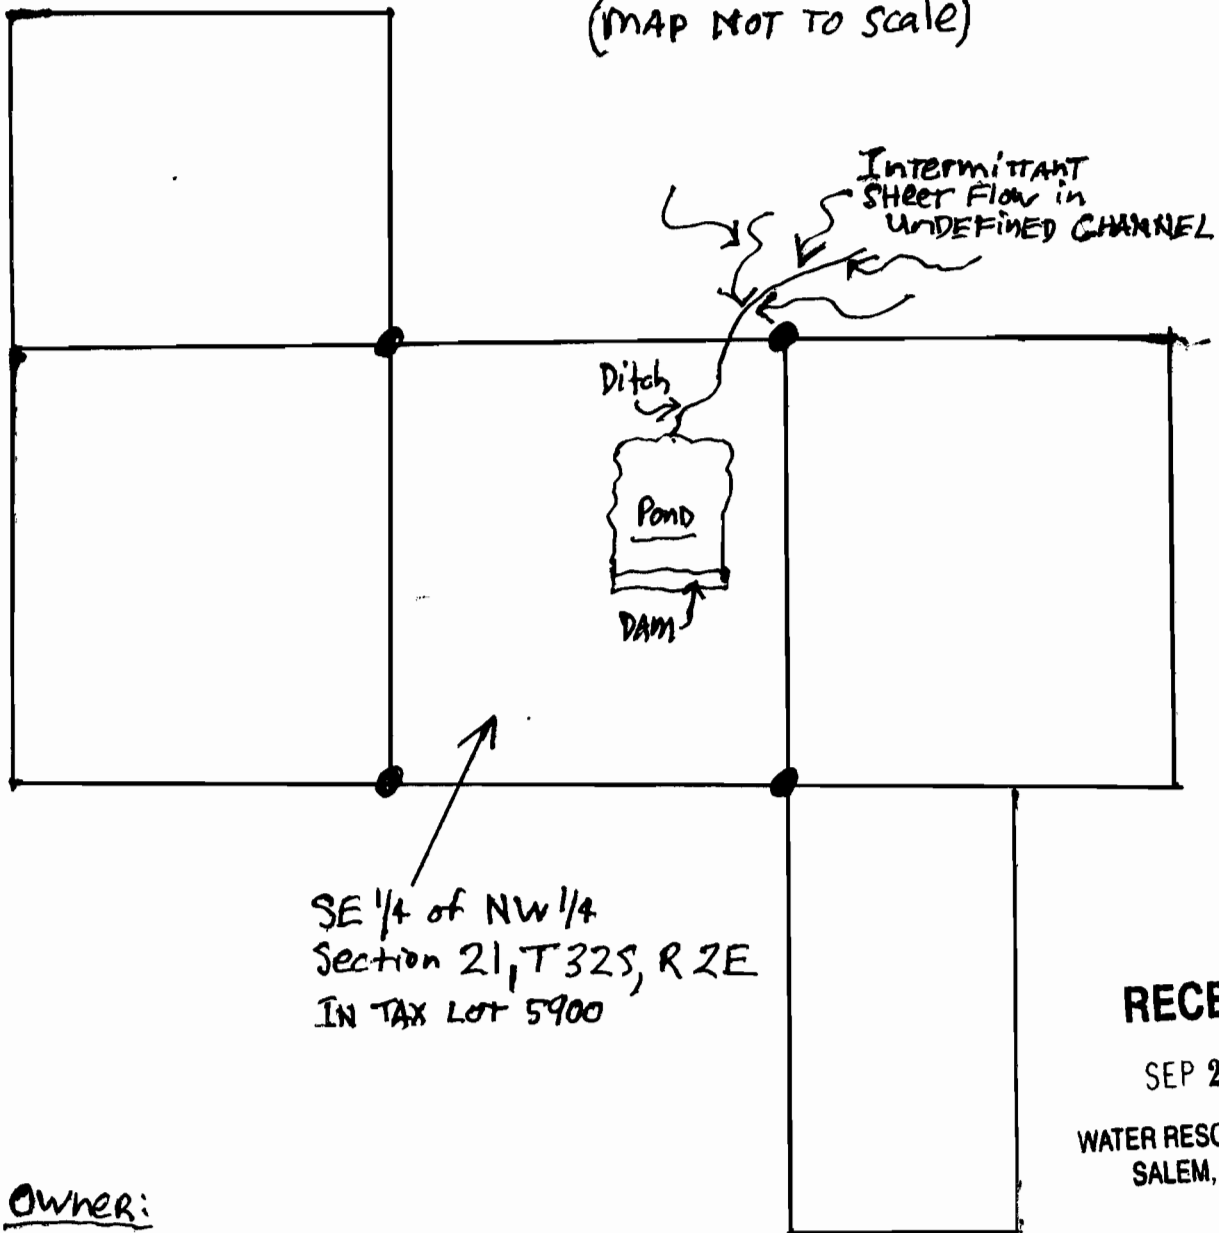

Owner:

Barry Stuart  
P.O. Box 9  
Trail, OR 97541

MAP INDICATES TOTAL SHUART PROPERTY OF  
182 Acres.