


COBU MAP FOR T-9801
 IN THE NAME OF JEDEDIAH W. AYLETT
 T4N, R27E, W.M., MORROW COUNTY

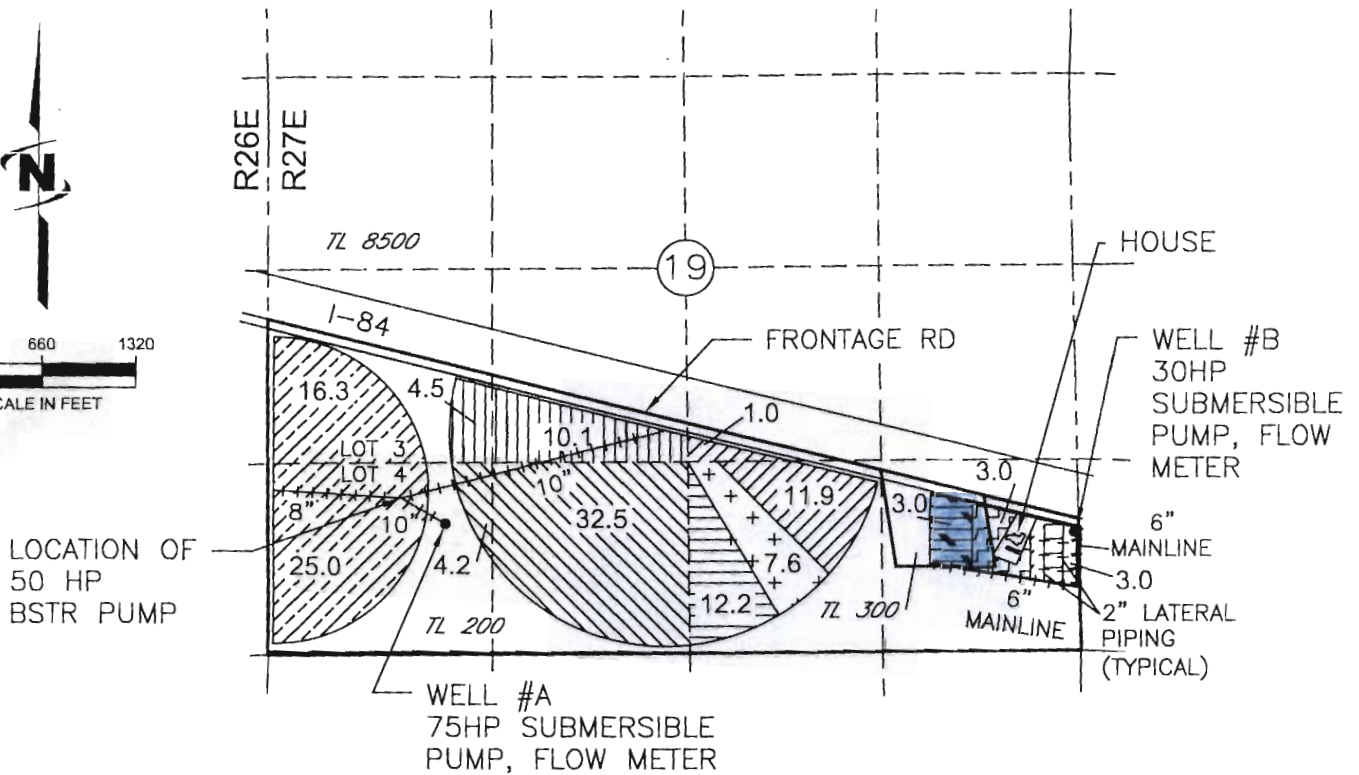

WELL #A LOCATED 865'N AND 1210'E FROM THE SW COR SEC 19


WELL #B LOCATED 790'N AND 55'W FROM THE SE COR SEC 19

LEGEND (IRRIGATED ACREAGE)

| FROM WELL #A | | FROM WELL #B | |
|--------------|---------------------------|--------------|---------------------------|
| | ORIGINATING CERT 72145 | | ORIGINATING CERT 72148 |
| | ORIGINATING CERT 72146 | | ORIGINATING CERT 72149 |
| | ORIGINATING CERT 72147 | | ORIGINATING CERT 72150 |
| | | | ORIGINATING CERT 60556 |
| | | | ORIGINATING CERT 68430 |
| | | | ORIGINATING CERT 68431 |

NOTE:
 THE PURPOSE OF THIS MAP IS TO IDENTIFY THE APPROXIMATE LOCATION OF THE WATER RIGHT. IT IS NOT INTENDED TO PROVIDE INFORMATION RELATIVE TO THE LOCATION OF PROPERTY OWNERSHIP BOUNDARY LINES.

THE PIPE DISTRIBUTION SYSTEM IS BURIED PIPE. LOCATIONS AND SIZES ARE APPROXIMATE. THEY ARE BASED ON FARM MAPS, FIELD OBSERVATIONS AND DESCRIPTIONS PROVIDED BY OPERATIONS PERSONNEL.

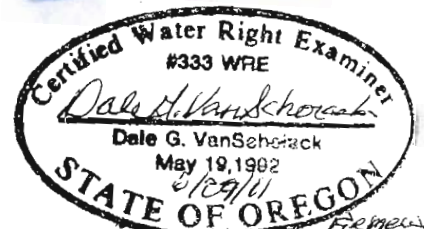

6/30/12