


6850
Coburn Map 2 of 2






 


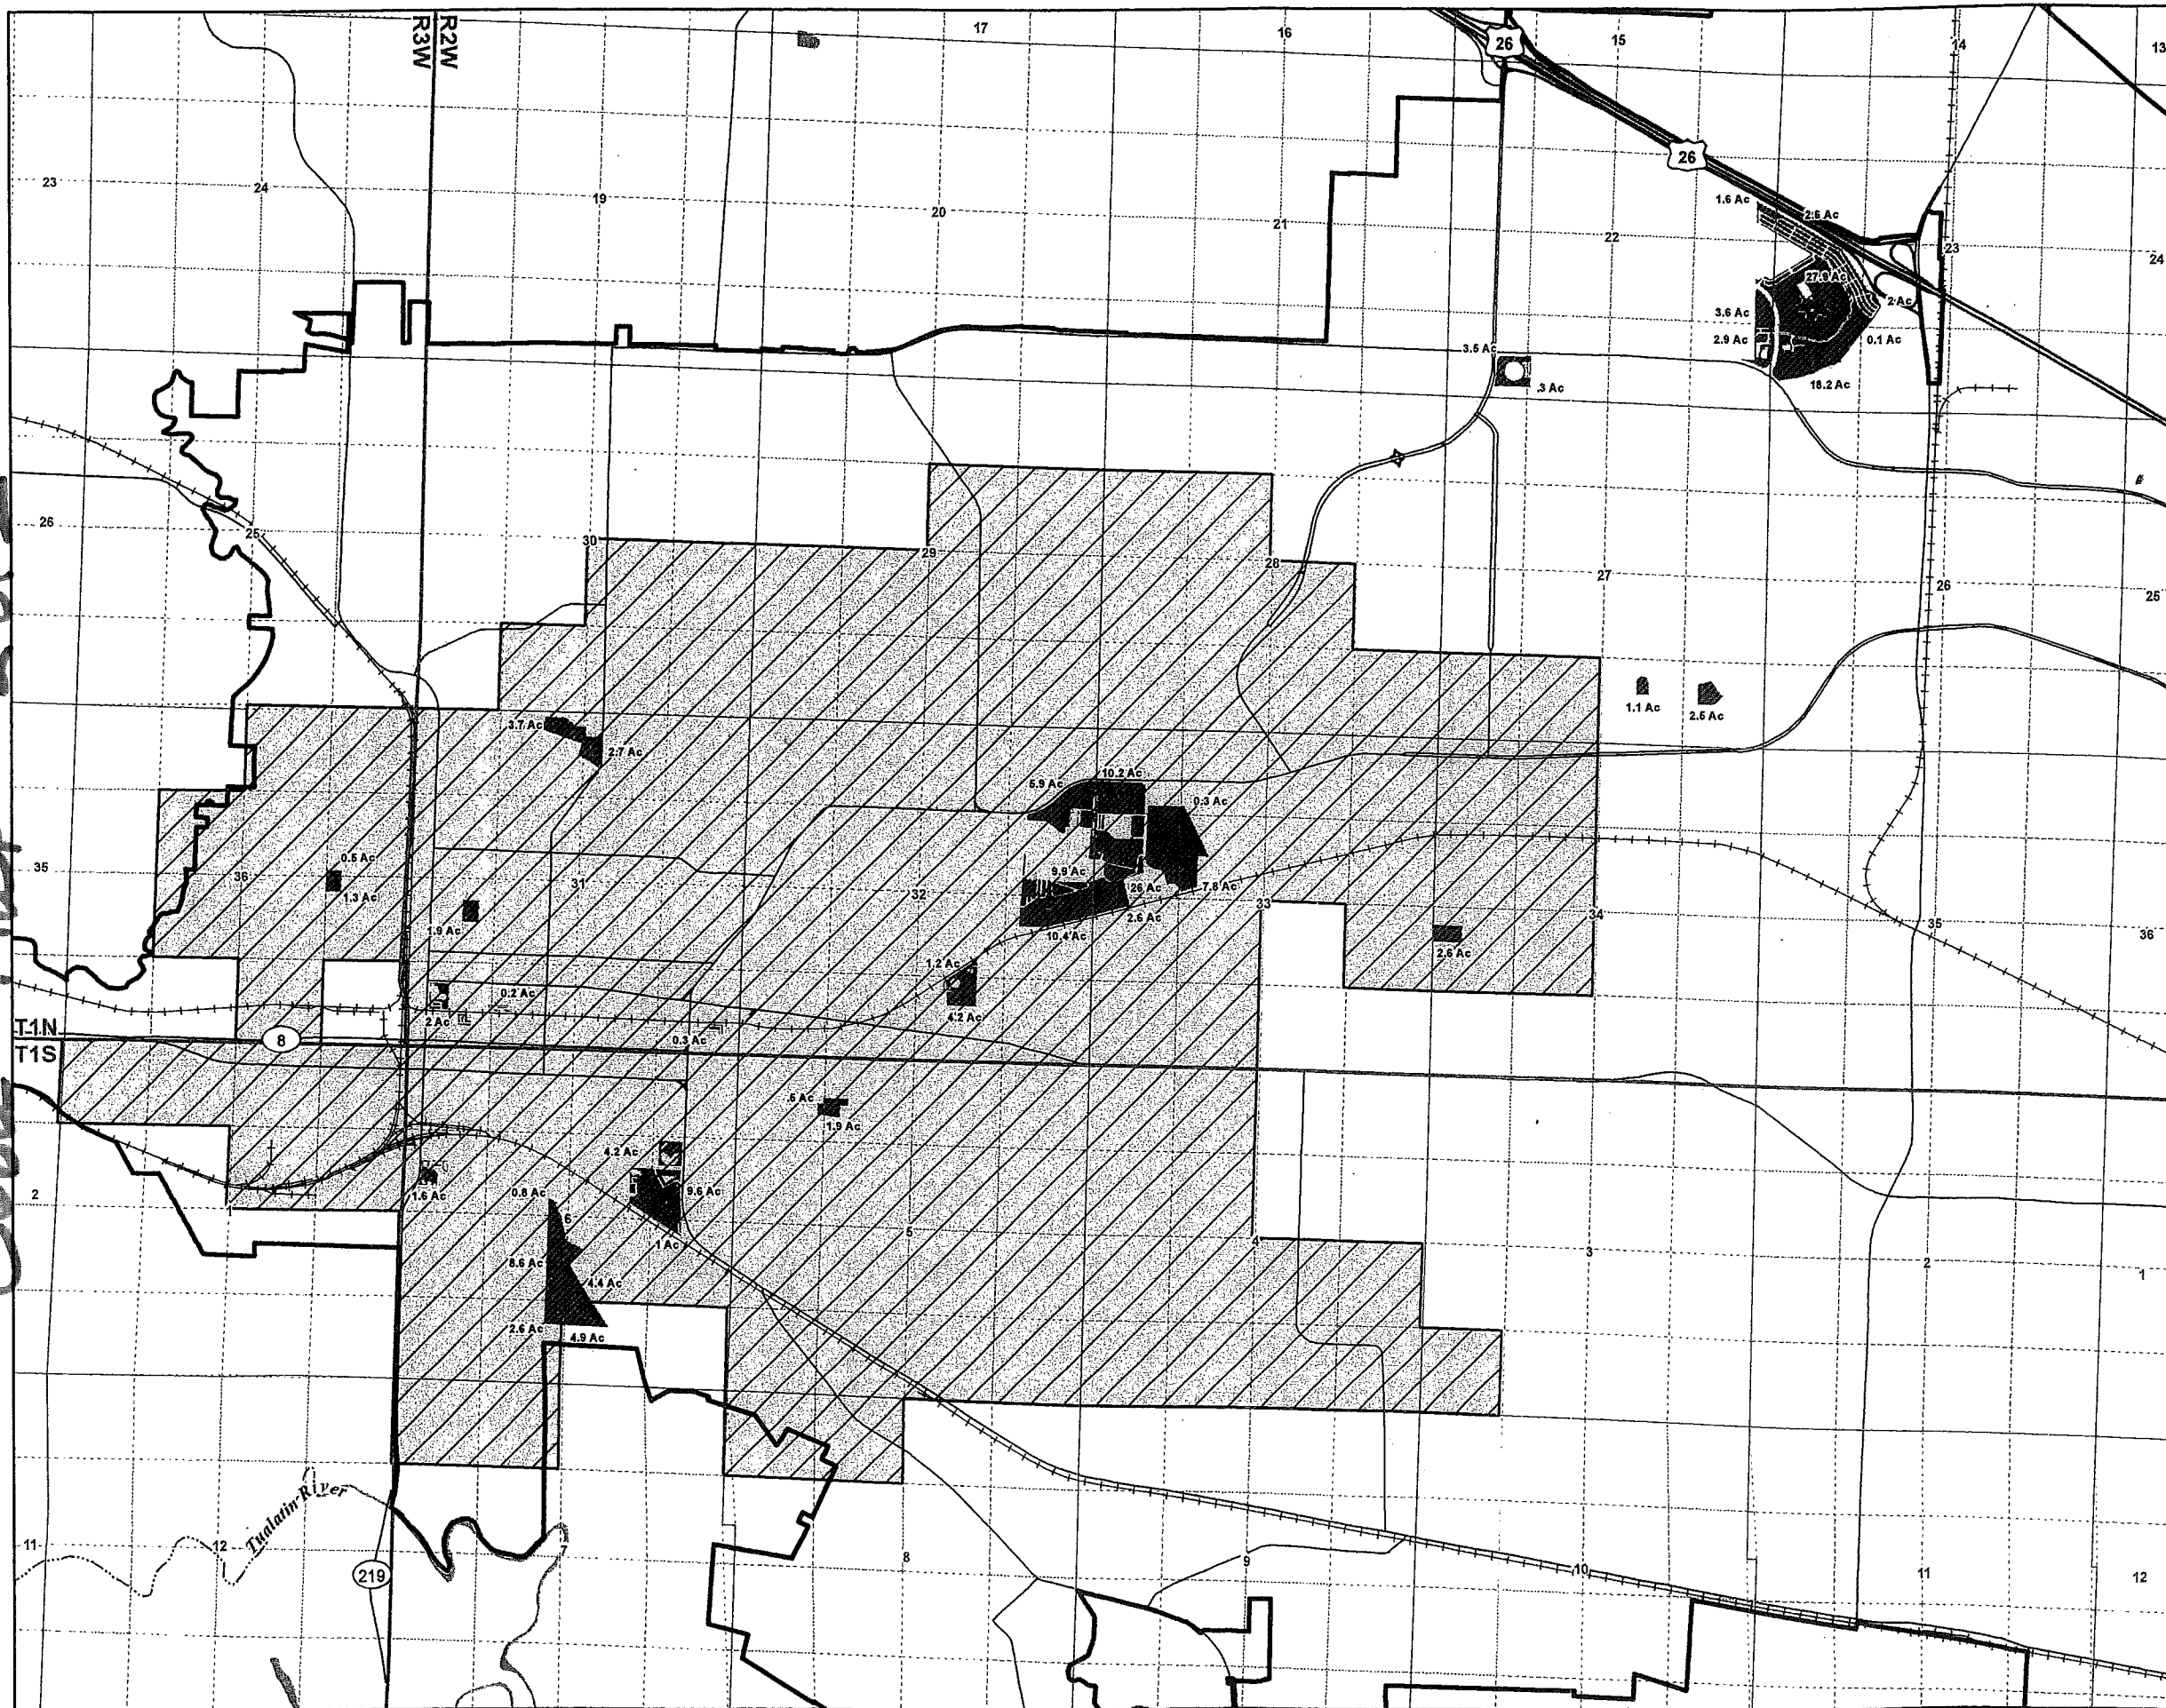

**Claim of Beneficial Use Map
Place of Use 2 of 2**

Permit S-35792 (Application S-38447)


Township 1 North & Townships 1 South,
Ranges 3 & 4 West (W.M.)

LEGEND

-  Place of Use (Municipal) for Permit S-35792
-  Place of Use (Irrigation) for Permit S-35792
-  Point of Diversion (POD)
-  JWC Service Area Boundary
-  Roads
-  Railroads
-  Watercourses
-  Waterbodies

RECEIVED



SEP 01 2010

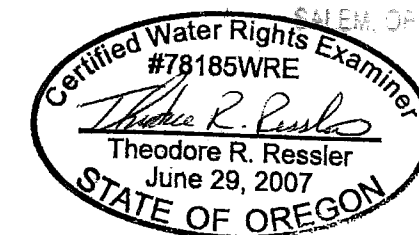

EXPIRES: 12-31-2010

DISCLAIMERS:

1. This map was prepared for the purpose of identifying the location of a water right only and it is not intended to provide legal dimensions or location of property ownership lines.

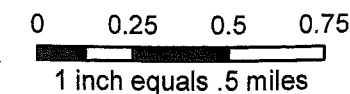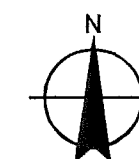


MAP NOTES:

Projection: Oregon State Plane North Zone
Datum: North American Datum of 1983
Date: August 30, 2010
Data Sources: OWRD, Oregon Geospatial Data Clearinghouse



0580
0581
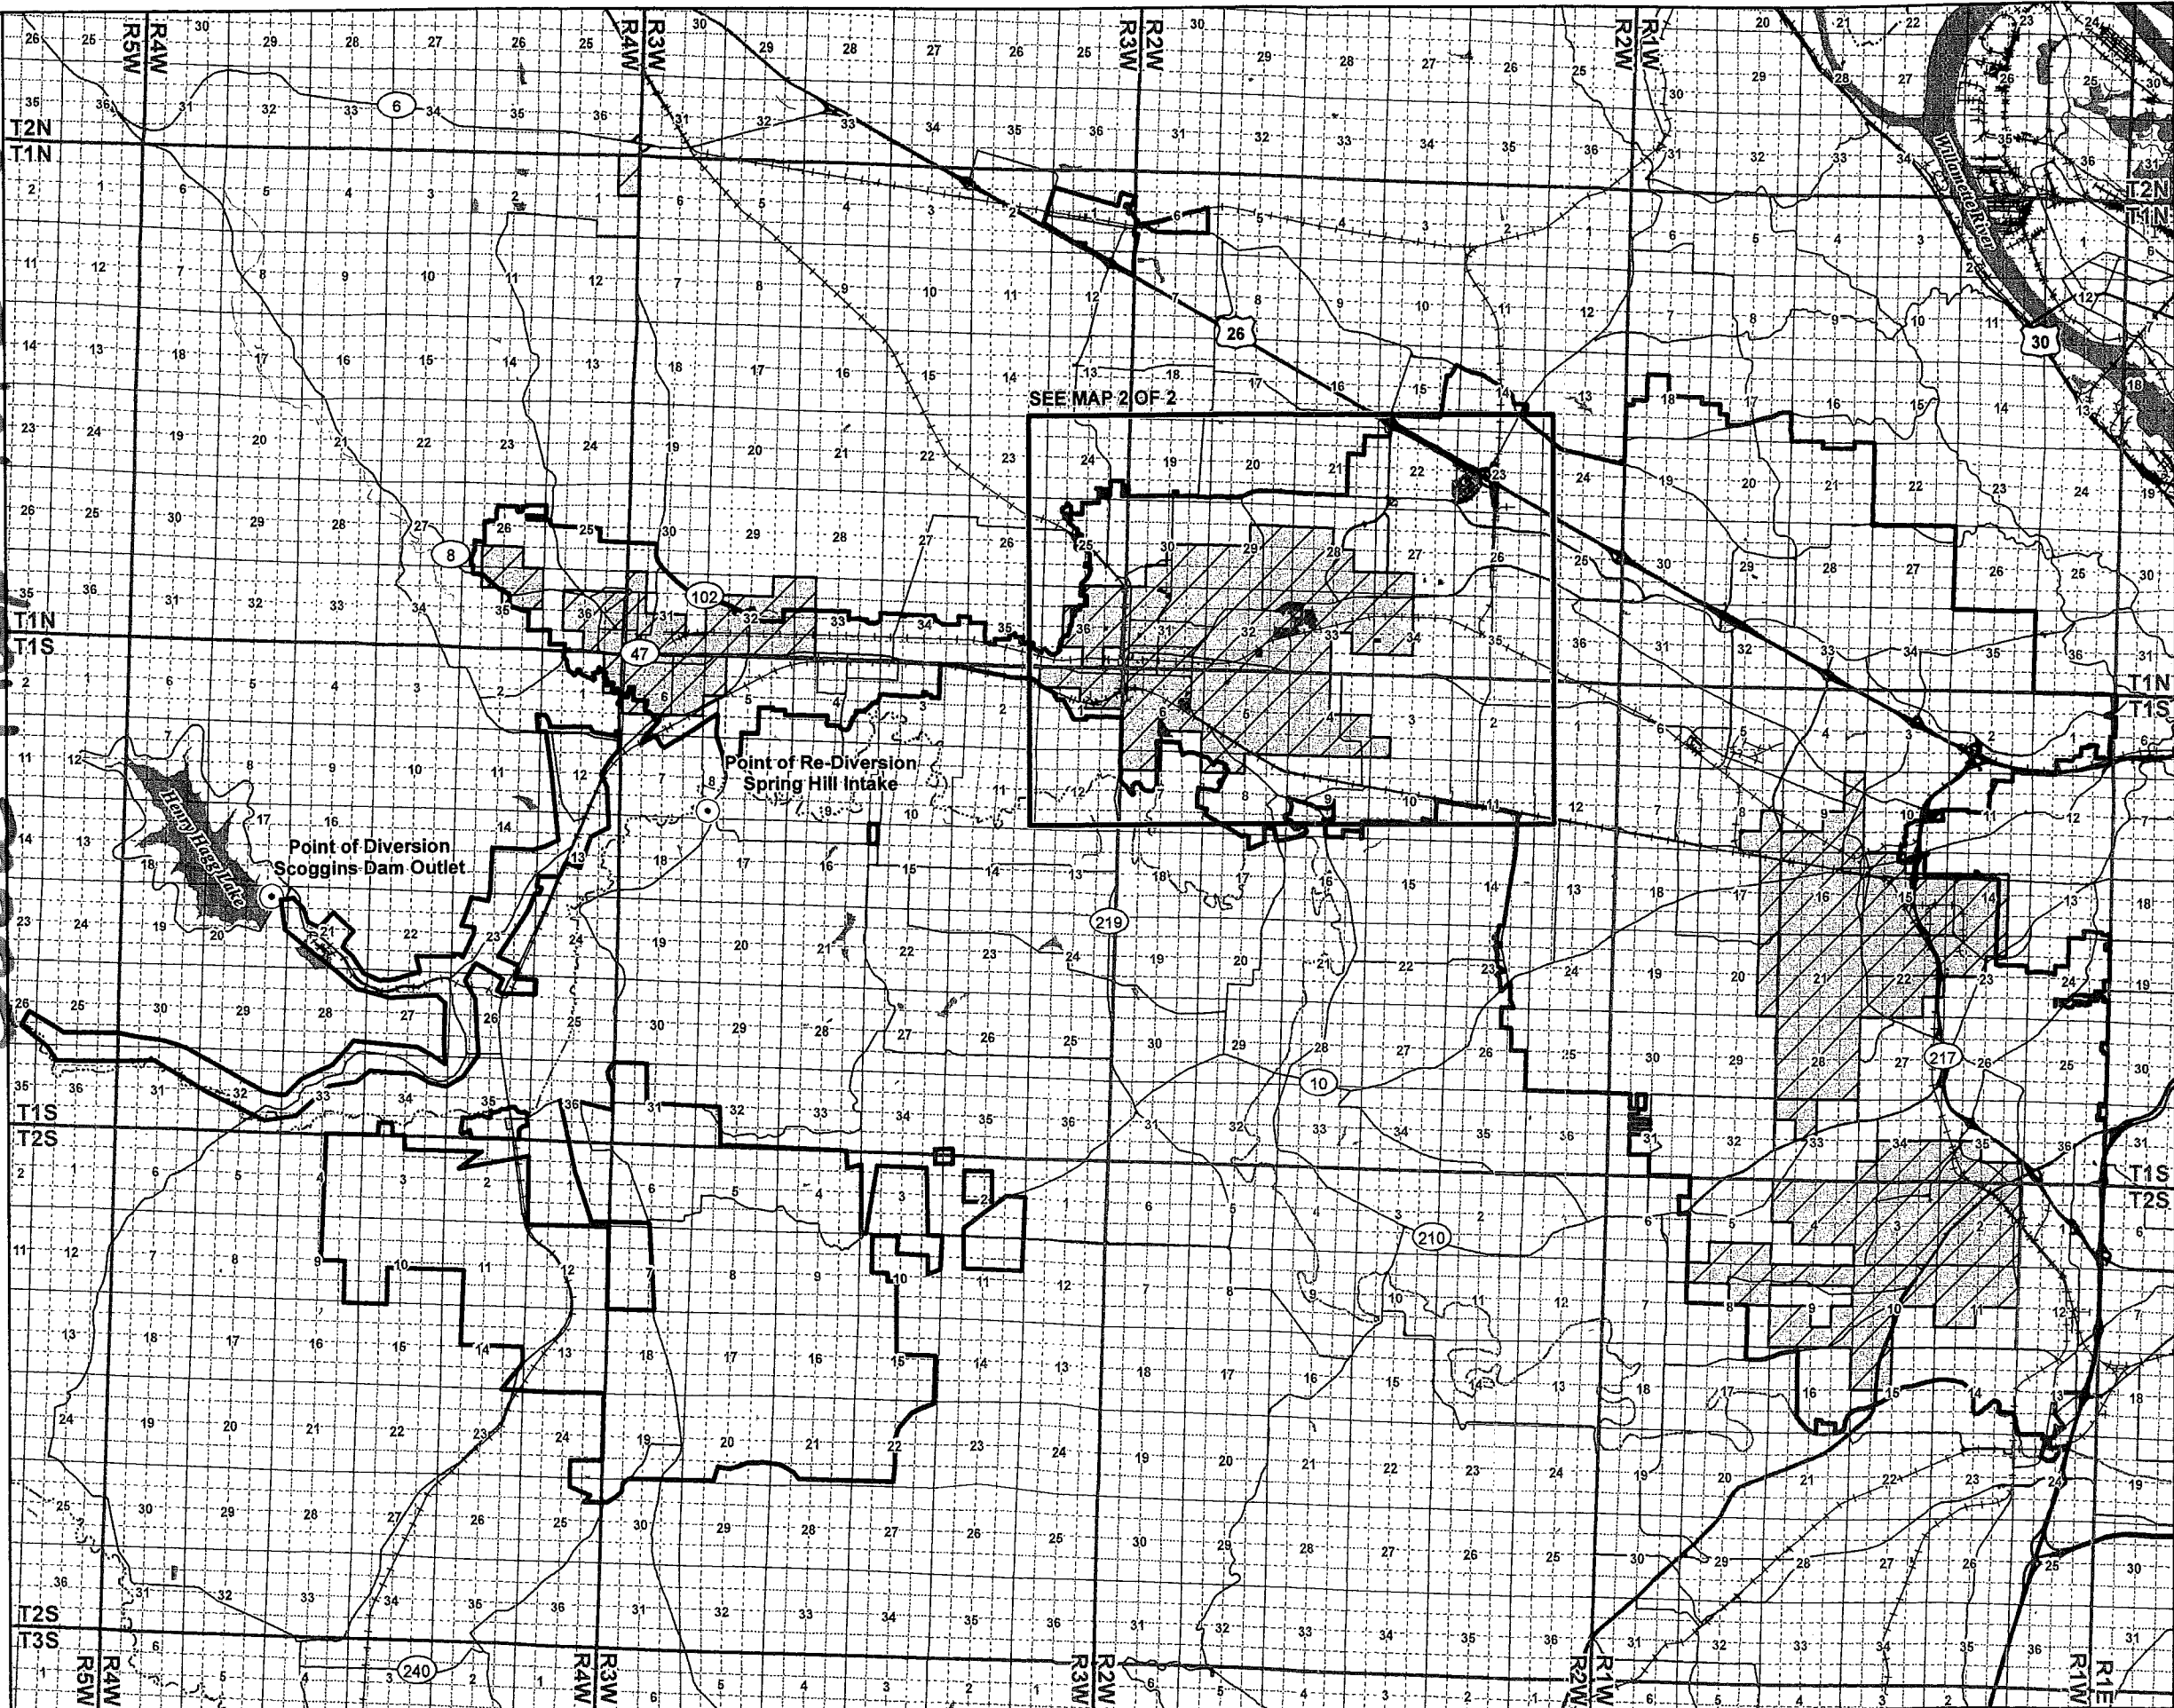









**Claim of Beneficial Use Map
Place of Use 1 of 2**


Permit S-35792 (Application S-38447)

Township 1 North & Townships 1 & 2 South,
Ranges 1, 2, 3, 4, & 5 West (W.M.)

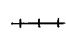LEGEND

-  Place of Use (Municipal) for Permit S-35792
-  Place of Use (Irrigation) for Permit S-35792
-  Point of Diversion (POD)
-  JWC Service Area Boundary
-  Roads
-  Railroads
-  Watercourses
-  Waterbodies



RECEIVED
SEP 01 2010
RESOURCES
DIVISION

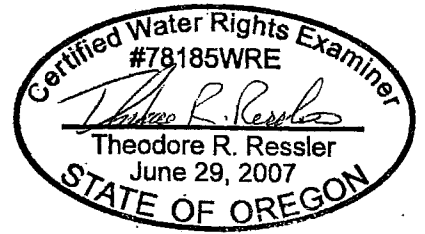

EXPIRES: 12-31-2010

DISCLAIMERS:

1. This map was prepared for the purpose of identifying the location of a water right only and it is not intended to provide legal dimensions or location of property ownership lines.

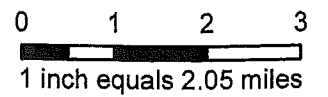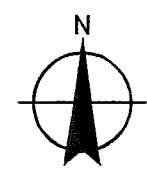


MAP NOTES:

Projection: Oregon State Plane North Zone
Datum: North American Datum of 1983
Date: August 30, 2010
Data Sources: OWRD, Oregon Geospatial Data Clearinghouse



Claim of Beneficial Use Map Point of Diversion

Permit S-35792 (Application S-38447)
Township 1 South, Range 4 West (W.M.)

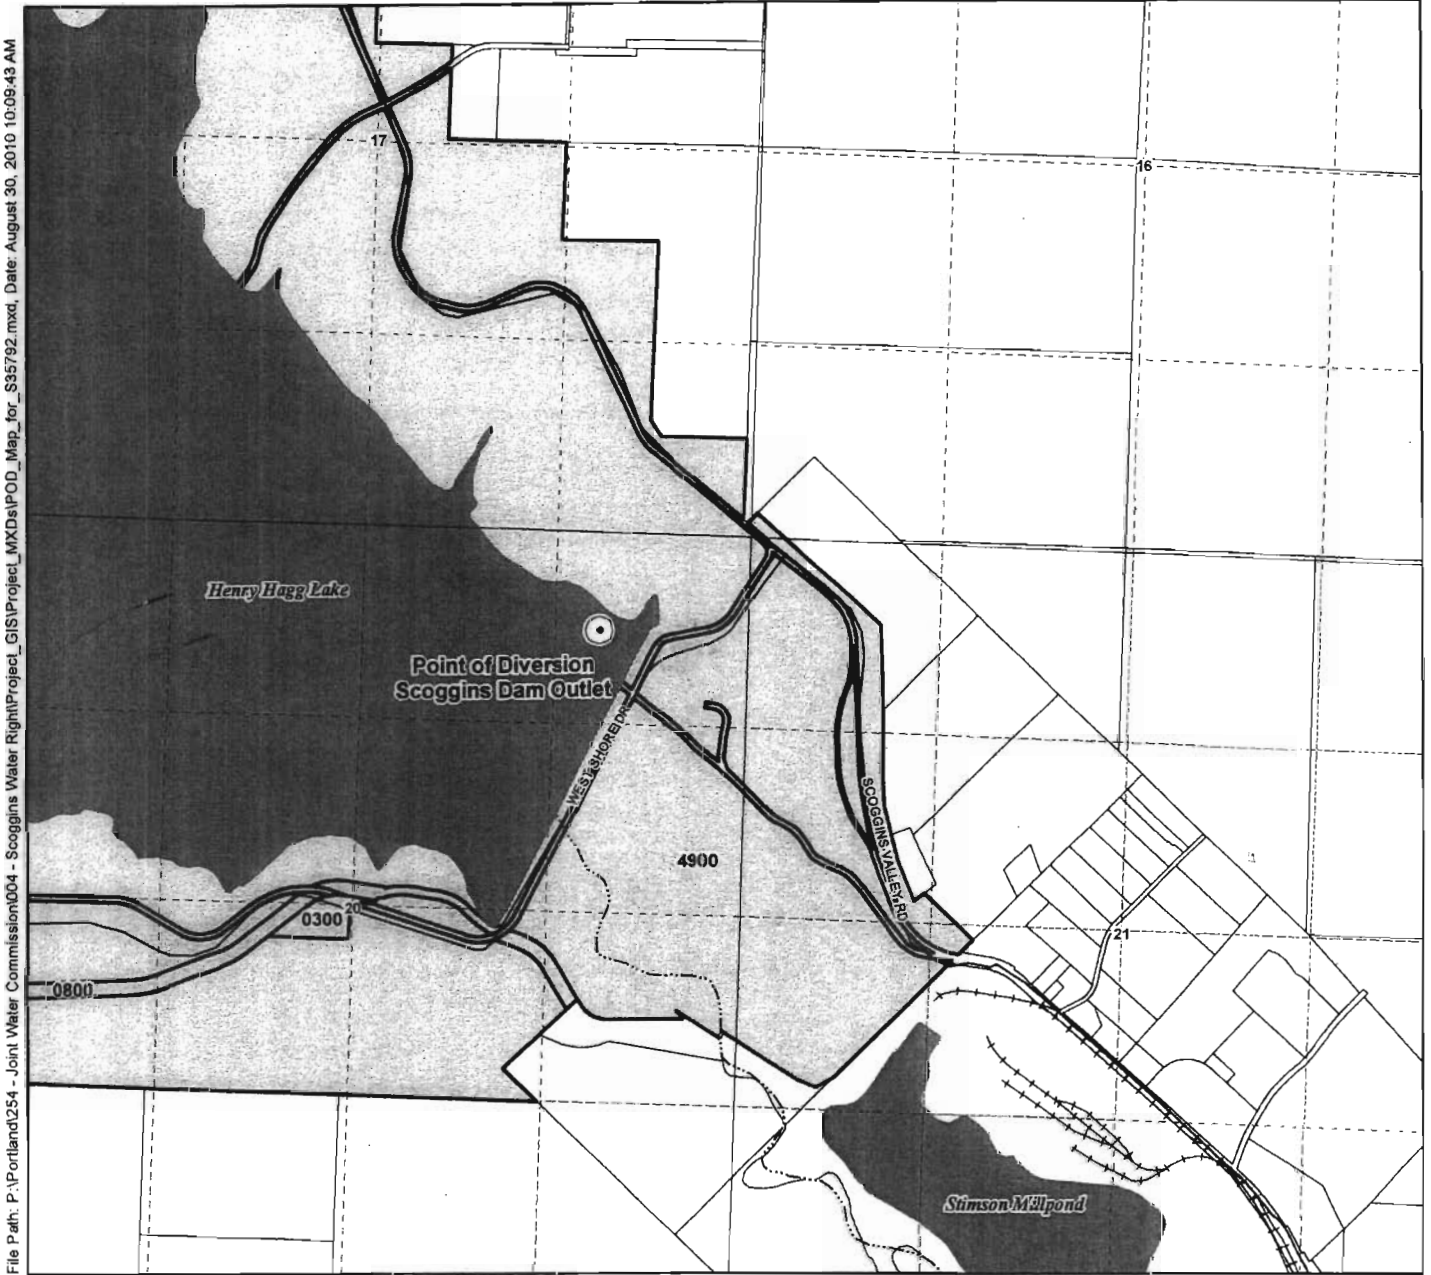

File Path: P:\Portland\254 - Joint Water Commission\004 - Scoggins Water Right\Project_GIS\Project_MXD\POD_Map_for_S35792.mxd, Date: August 30, 2010 10:09:43 AM

Legend

- Point of Diversion (POD)
- Taxlots
- Taxlots owned by Bureau of Reclamation
- Roads
- Railroads
- Watercourses
- Waterbodies


POD Legal Description

Scoggins Dam Located 700 feet South and 1030 feet West from the NE corner of Section 20, Township 1 South, Range 4 West (W.M.)

RECEIVED

SEP 01 2010

WATER RESOURCES
SALEM, ORE

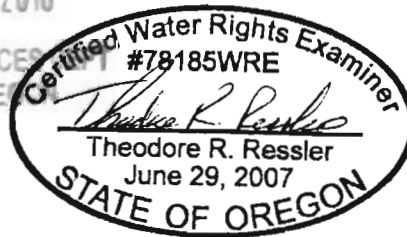

EXPIRES: 12-31-2010

Map Information


Projection: Oregon State Plane North Zone
Datum: North American Datum of 1983
Date: August 30, 2010
Prepared By: GSI Water Solutions, Inc.

Data Sources

OWRD, Oregon Geospatial Data Clearinghouse


Disclaimer

This map was prepared for the purpose of identifying the location of a water right only and it is not intended to provide legal dimensions or location of property ownership lines.

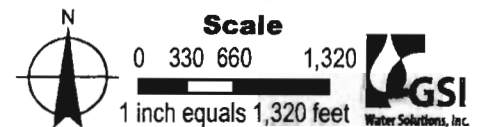

Claim of Beneficial Use Map Point of Re-Diversion

Permit S-35792 (Application S-38447)
Township 1 South, Range 3 West (W.M.)

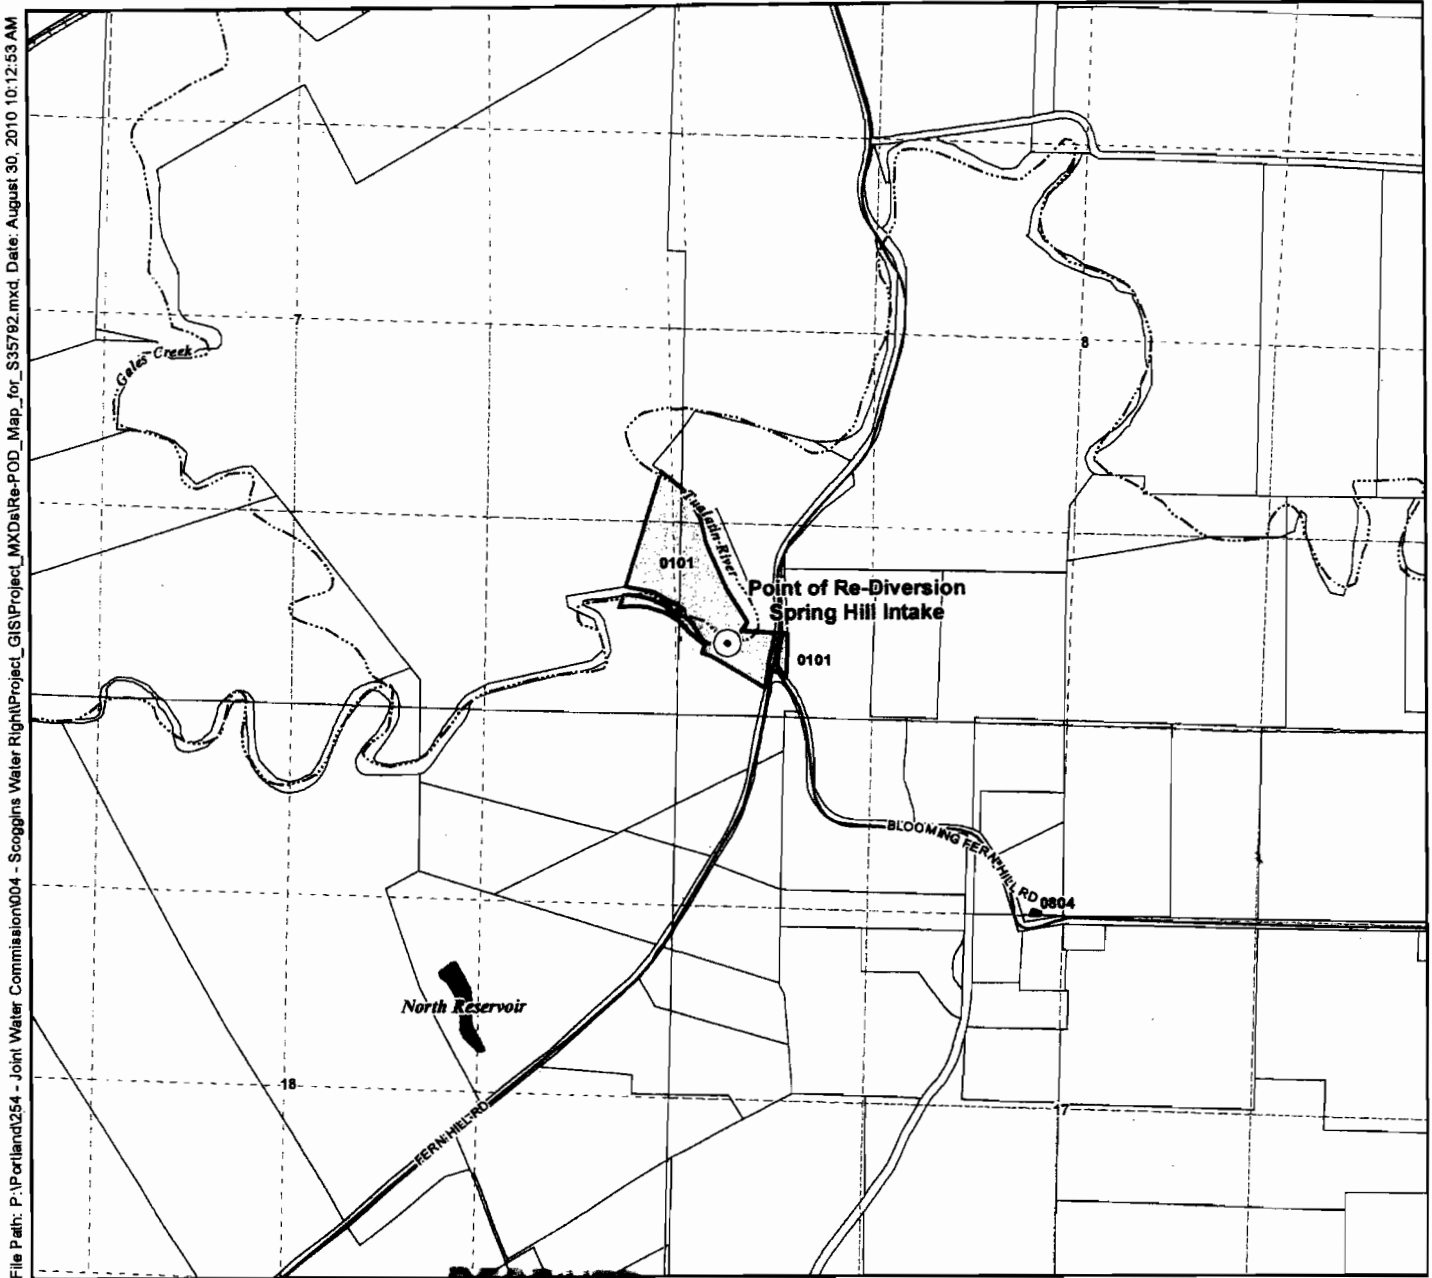

File Path: P:\Portland\254 - Joint Water Commission\004 - Scoggins Water Right\Project_GIS\Project_MXD\Re-POD_Map_for_S35792.mxd, Date: August 30, 2010 10:12:53 AM

Legend

- Point of Re-Diversion (POD)
- Taxlots
- Taxlots owned by Bureau of Reclamation
- Roads
- Railroads
- Watercourses
- Waterbodies

POD Legal Description


Point of Re-Diversion Located 500 feet North and 410 feet East from the SW corner of Section 8, Township 1 South, Range 3 West (W.M.)

RECEIVED

SEP 01 2010

WATER RESOURCES DEPT

STATE OF OREGON

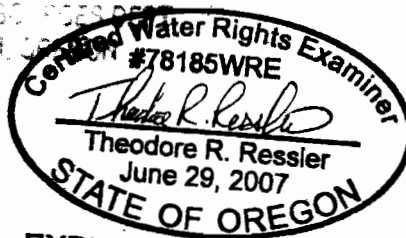

EXPIRES: 12-31-2010

Map Information

Projection: Oregon State Plane North Zone
Datum: North American Datum of 1983
Date: August 30, 2010
Prepared By: GSI Water Solutions, Inc.

Data Sources

OWRD, Oregon Geospatial Data Clearinghouse

Disclaimer

This map was prepared for the purpose of identifying the location of a water right only and it is not intended to provide legal dimensions or location of property ownership lines.



Scale

0 330 660 1,320

1 inch equals 1,320 feet

