


0580
0581
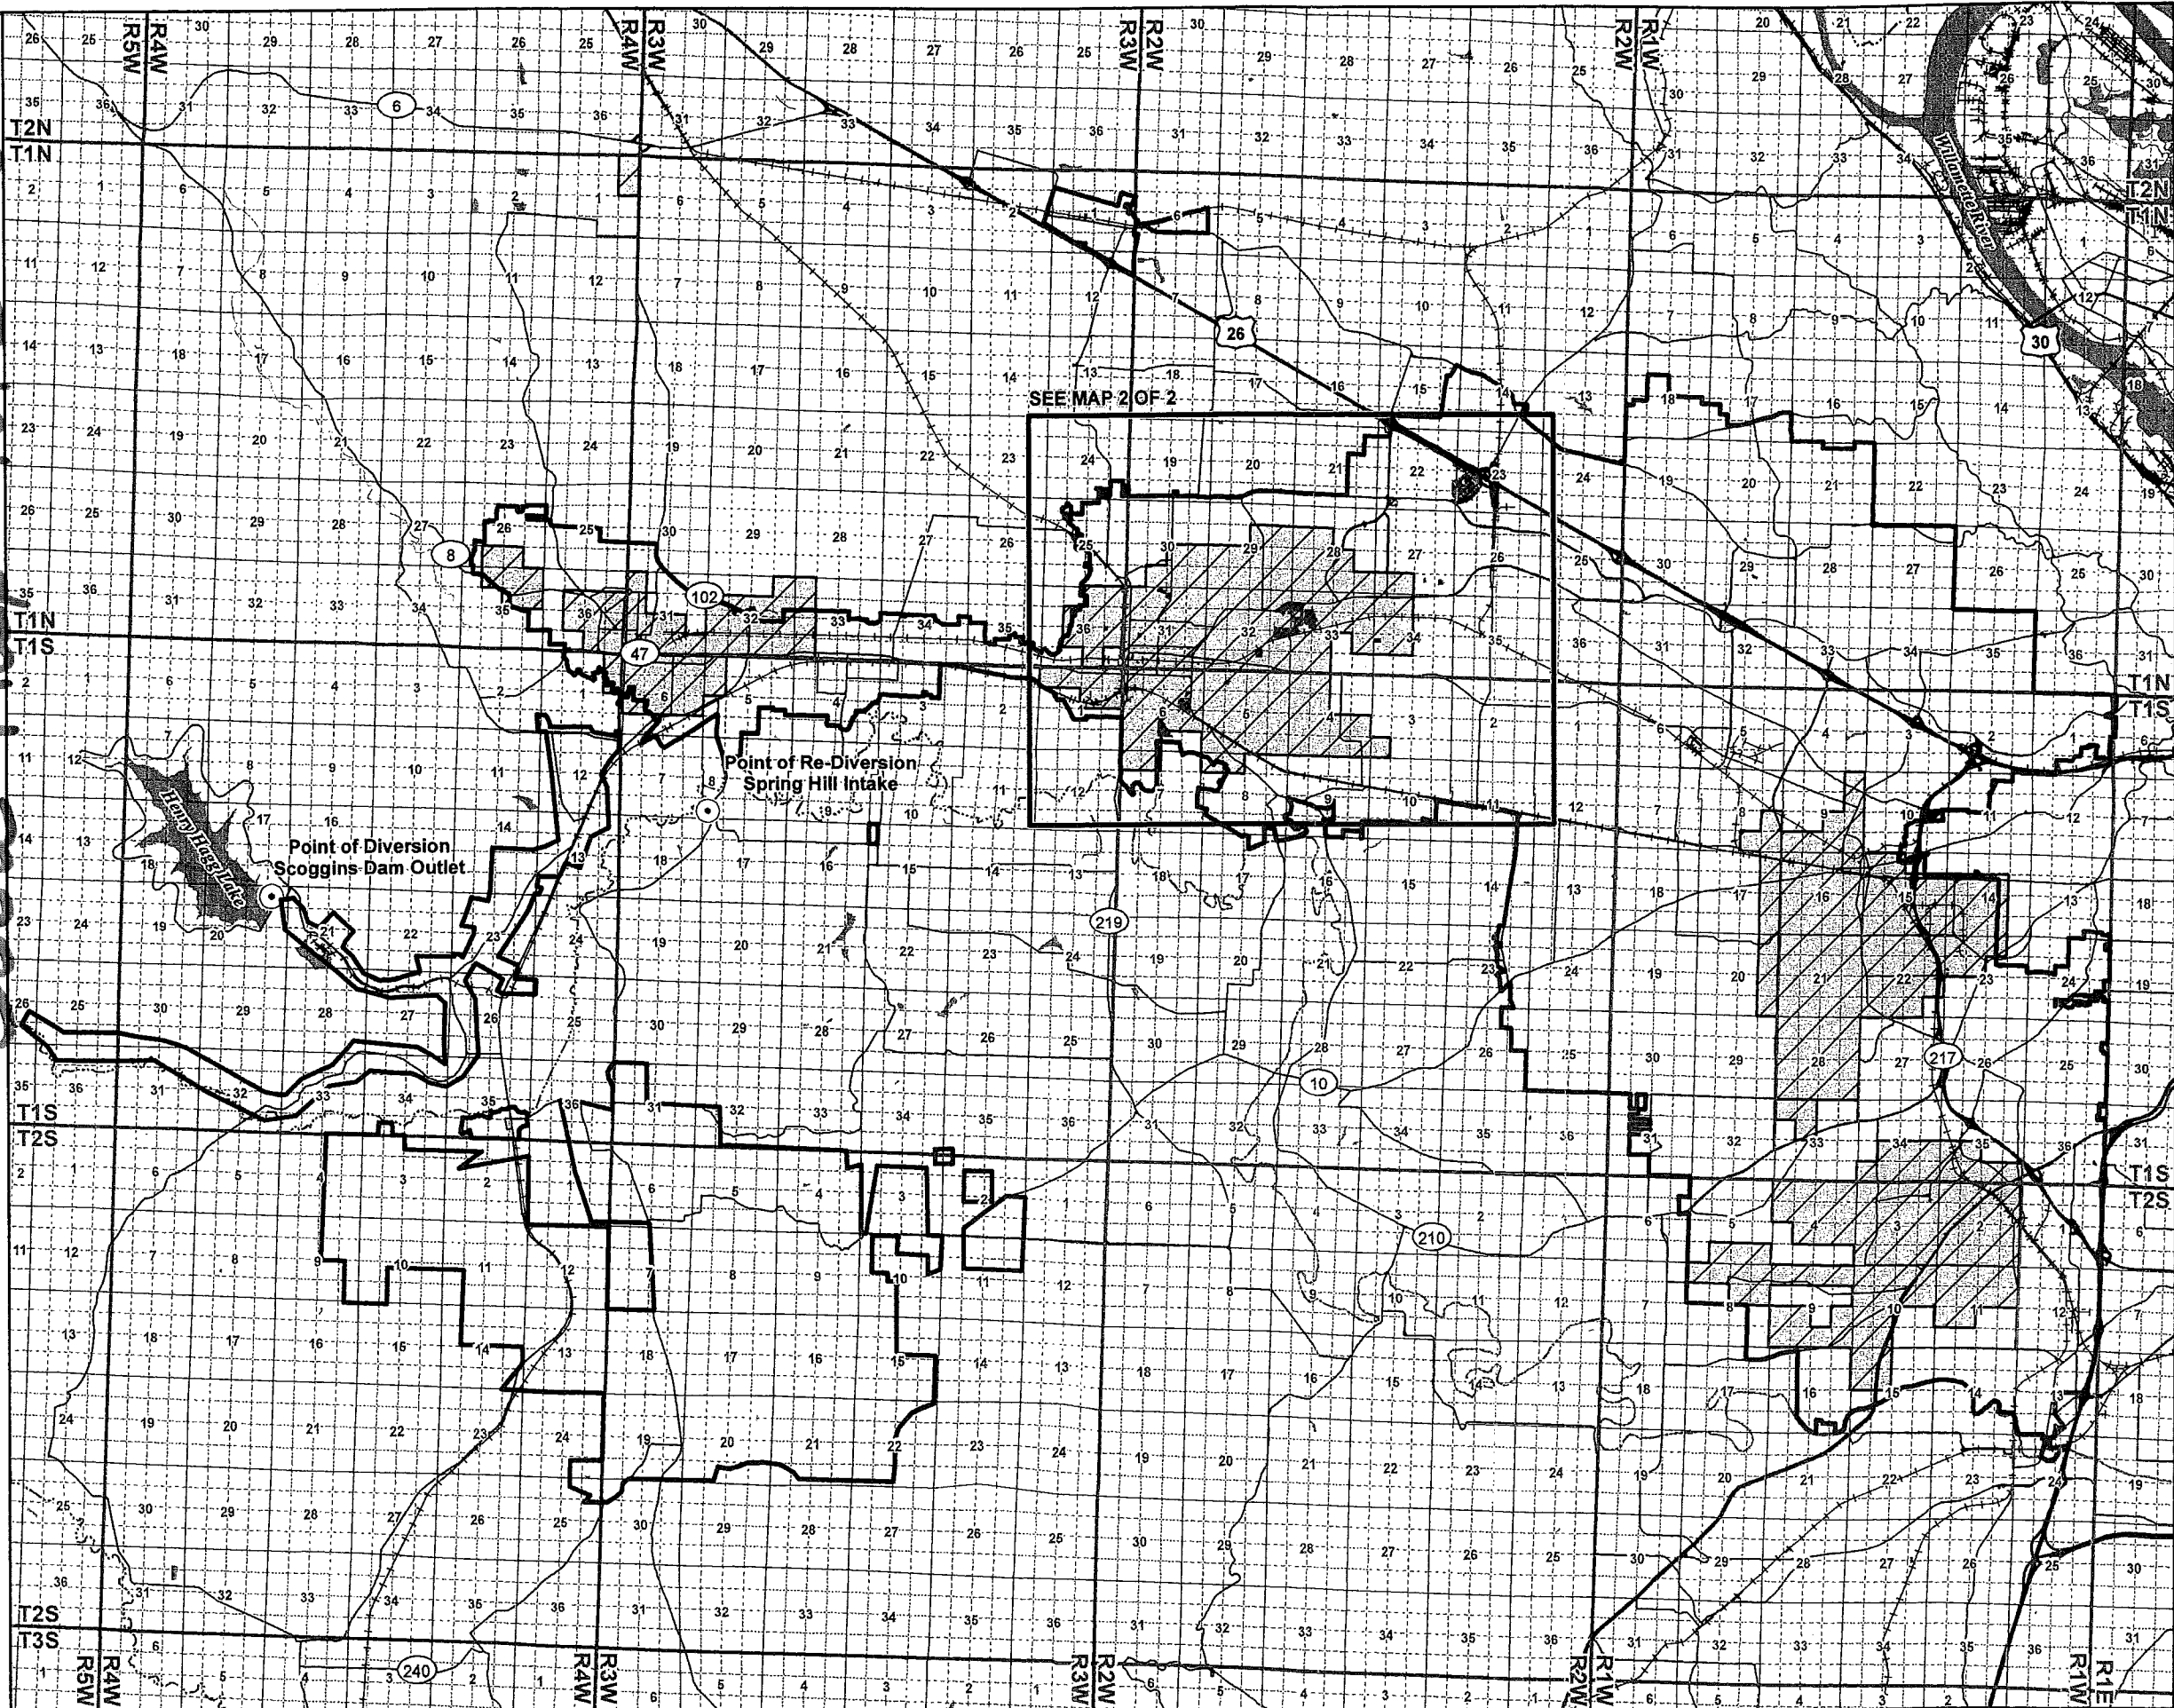


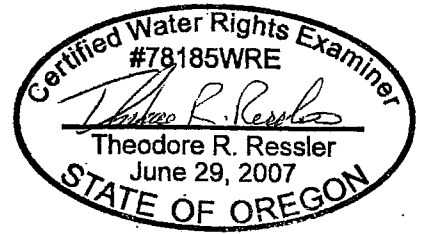
Claim of Beneficial Use Map Place of Use 1 of 2

Permit S-35792 (Application S-38447)

Township 1 North & Townships 1 & 2 South,
Ranges 1, 2, 3, 4, & 5 West (W.M.)

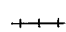
LEGEND

-  Place of Use (Municipal) for Permit S-35792
-  Place of Use (Irrigation) for Permit S-35792
-  Point of Diversion (POD)
-  JWC Service Area Boundary
-  Roads
-  Railroads
-  Watercourses
-  Waterbodies



EXPIRES: 12-31-2010

DISCLAIMERS:
1. This map was prepared for the purpose of identifying the location of a water right only and it is not intended to provide legal dimensions or location of property ownership lines.

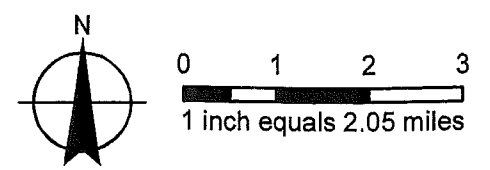


MAP NOTES:
Projection: Oregon State Plane North Zone
Datum: North American Datum of 1983
Date: August 30, 2010
Data Sources: OWRD, Oregon Geospatial Data Clearinghouse



RECEIVED
SEP 01 2010
RESOURCES
OF OREGON

6850
Coburn Map 2 of 2

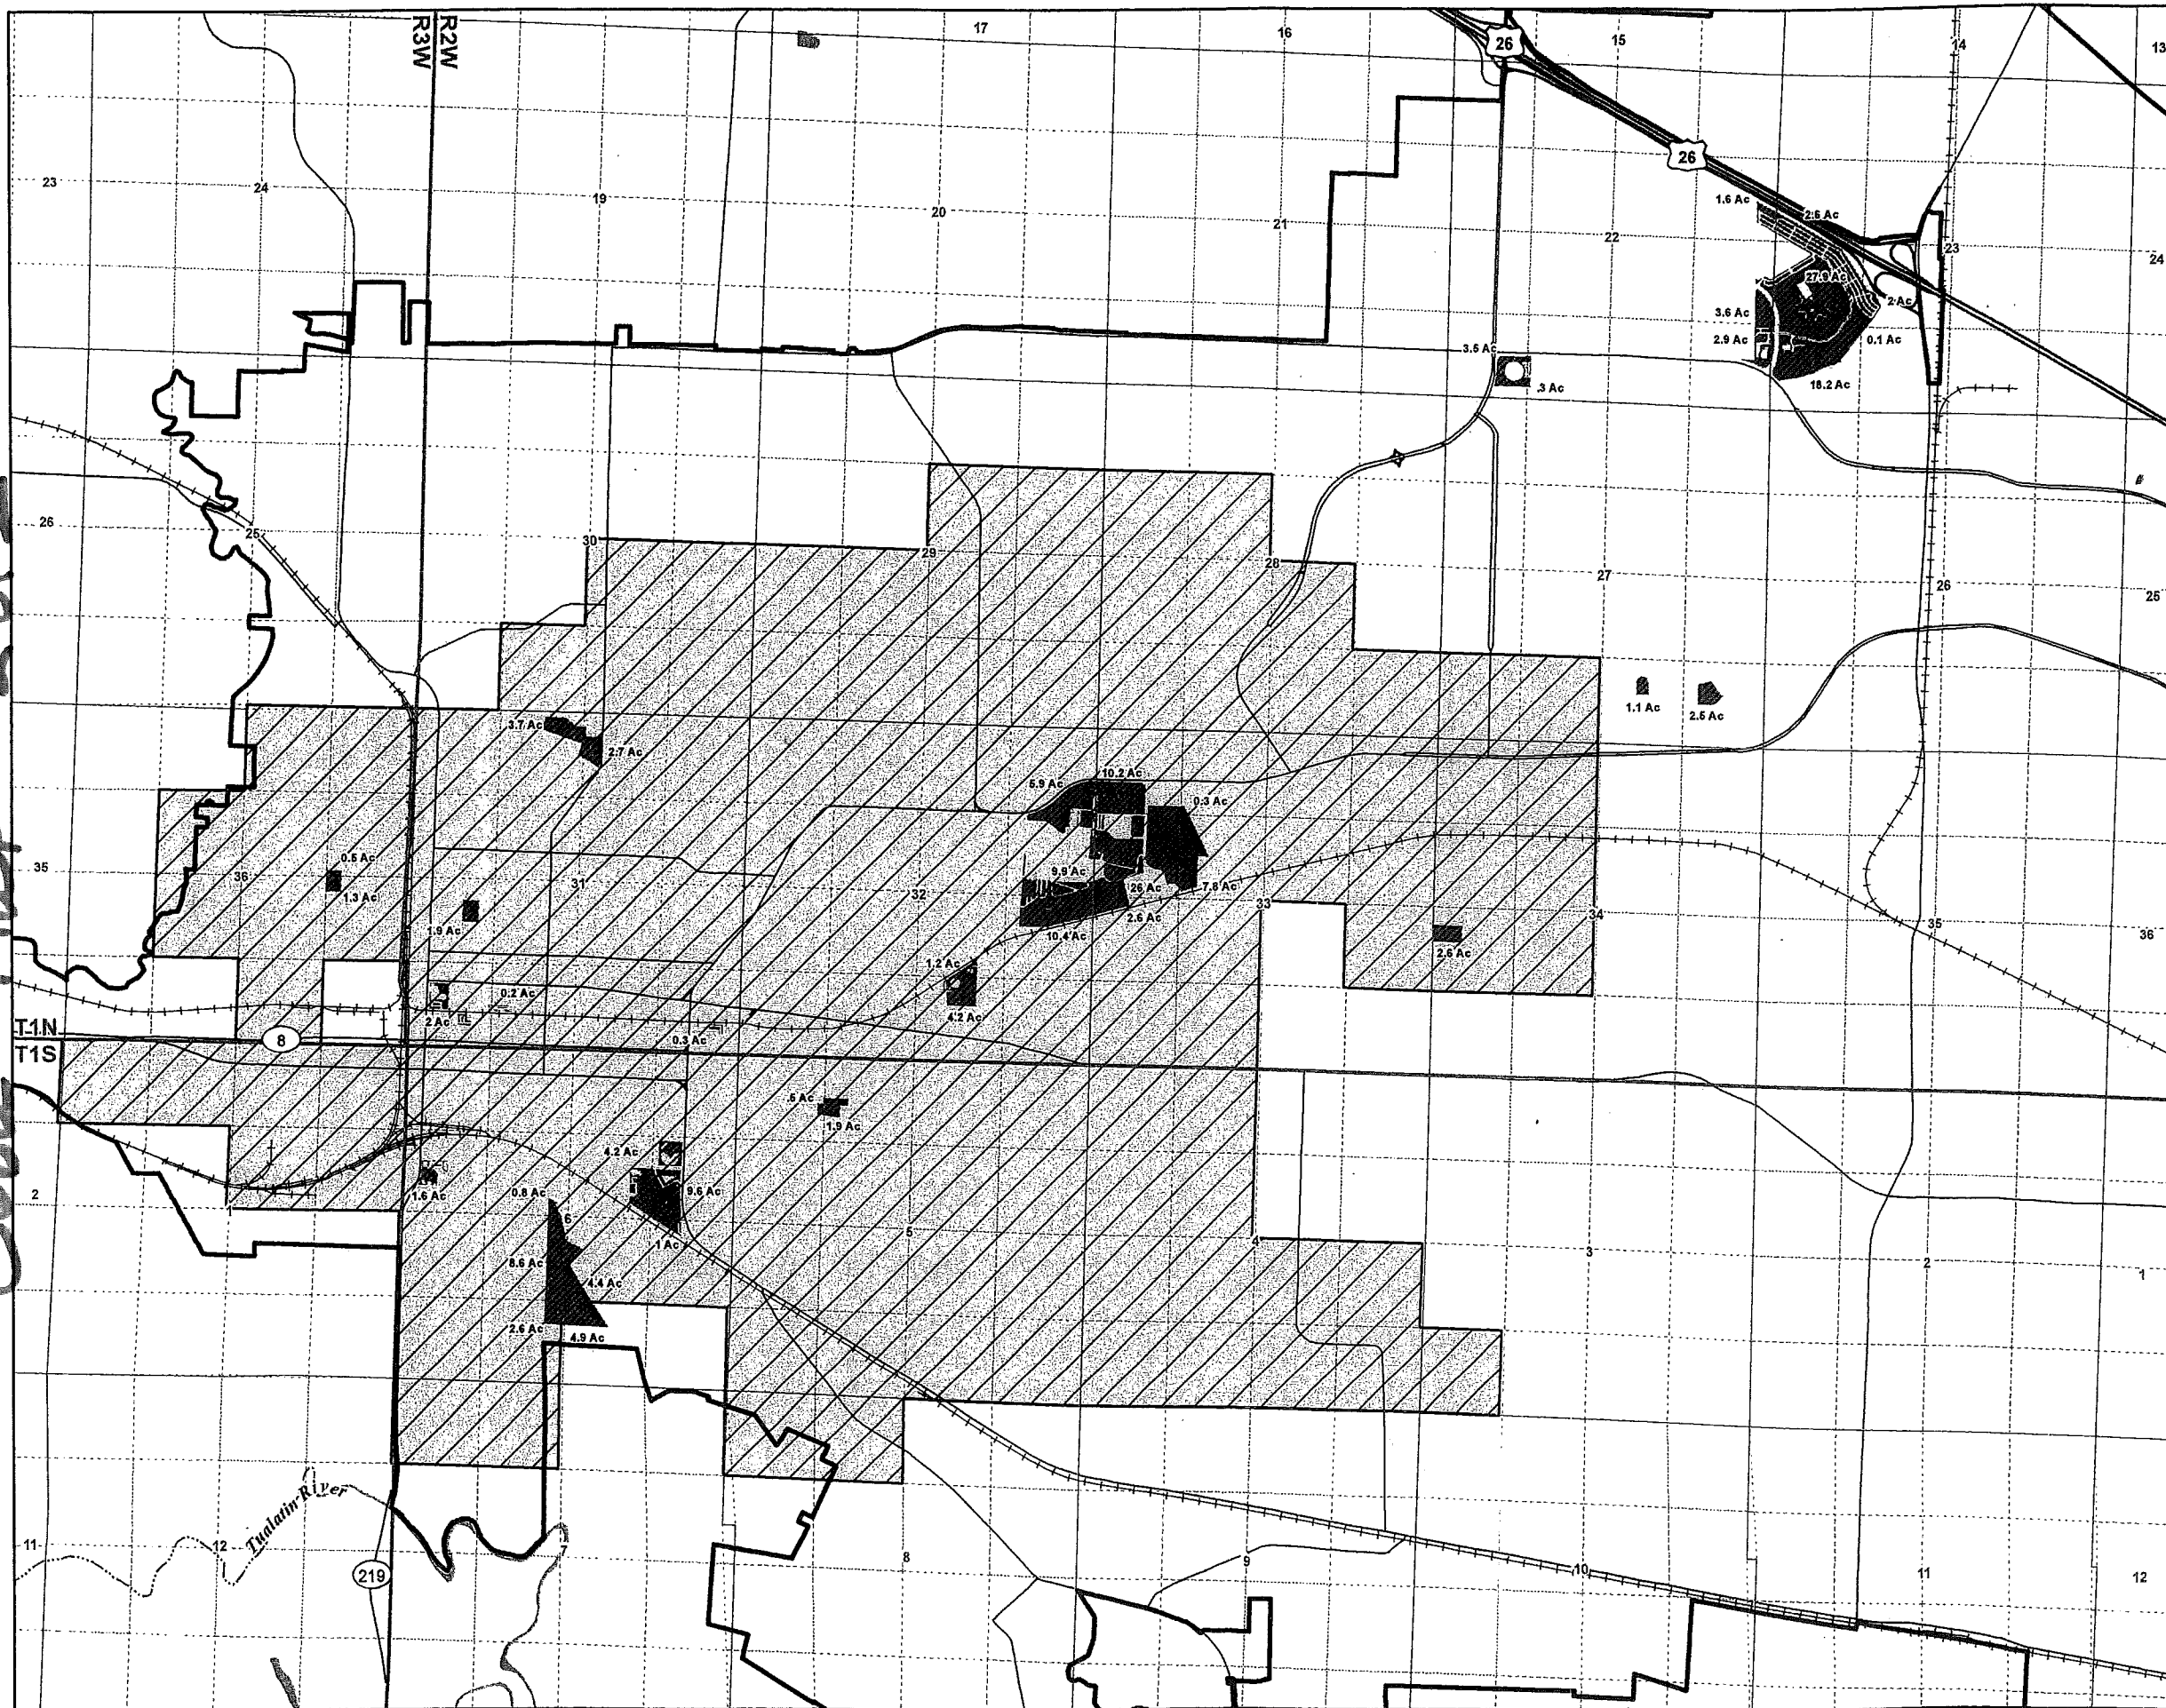

**Claim of Beneficial Use Map
Place of Use 2 of 2**

Permit S-35792 (Application S-38447)


Township 1 North & Townships 1 South,
Ranges 3 & 4 West (W.M.)

LEGEND

- Place of Use (Municipal) for Permit S-35792
- Place of Use (Irrigation) for Permit S-35792
- Point of Diversion (POD)
- JWC Service Area Boundary
- Roads
- Railroads
- Watercourses
- Waterbodies

RECEIVED


SEP 01 2010

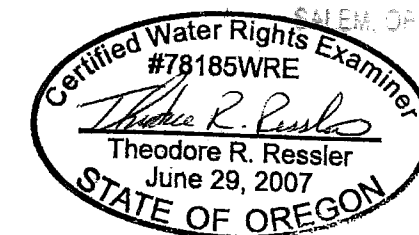

EXPIRES: 12-31-2010

DISCLAIMERS:

1. This map was prepared for the purpose of identifying the location of a water right only and it is not intended to provide legal dimensions or location of property ownership lines.

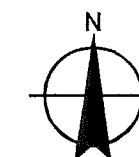

0 0.25 0.5 0.75
1 inch equals .5 miles


MAP NOTES:

Projection: Oregon State Plane North Zone
Datum: North American Datum of 1983
Date: August 30, 2010
Data Sources: OWRD, Oregon Geospatial Data Clearinghouse



Claim of Beneficial Use Map Point of Diversion

Permit S-35792 (Application S-38447)
Township 1 South, Range 4 West (W.M.)

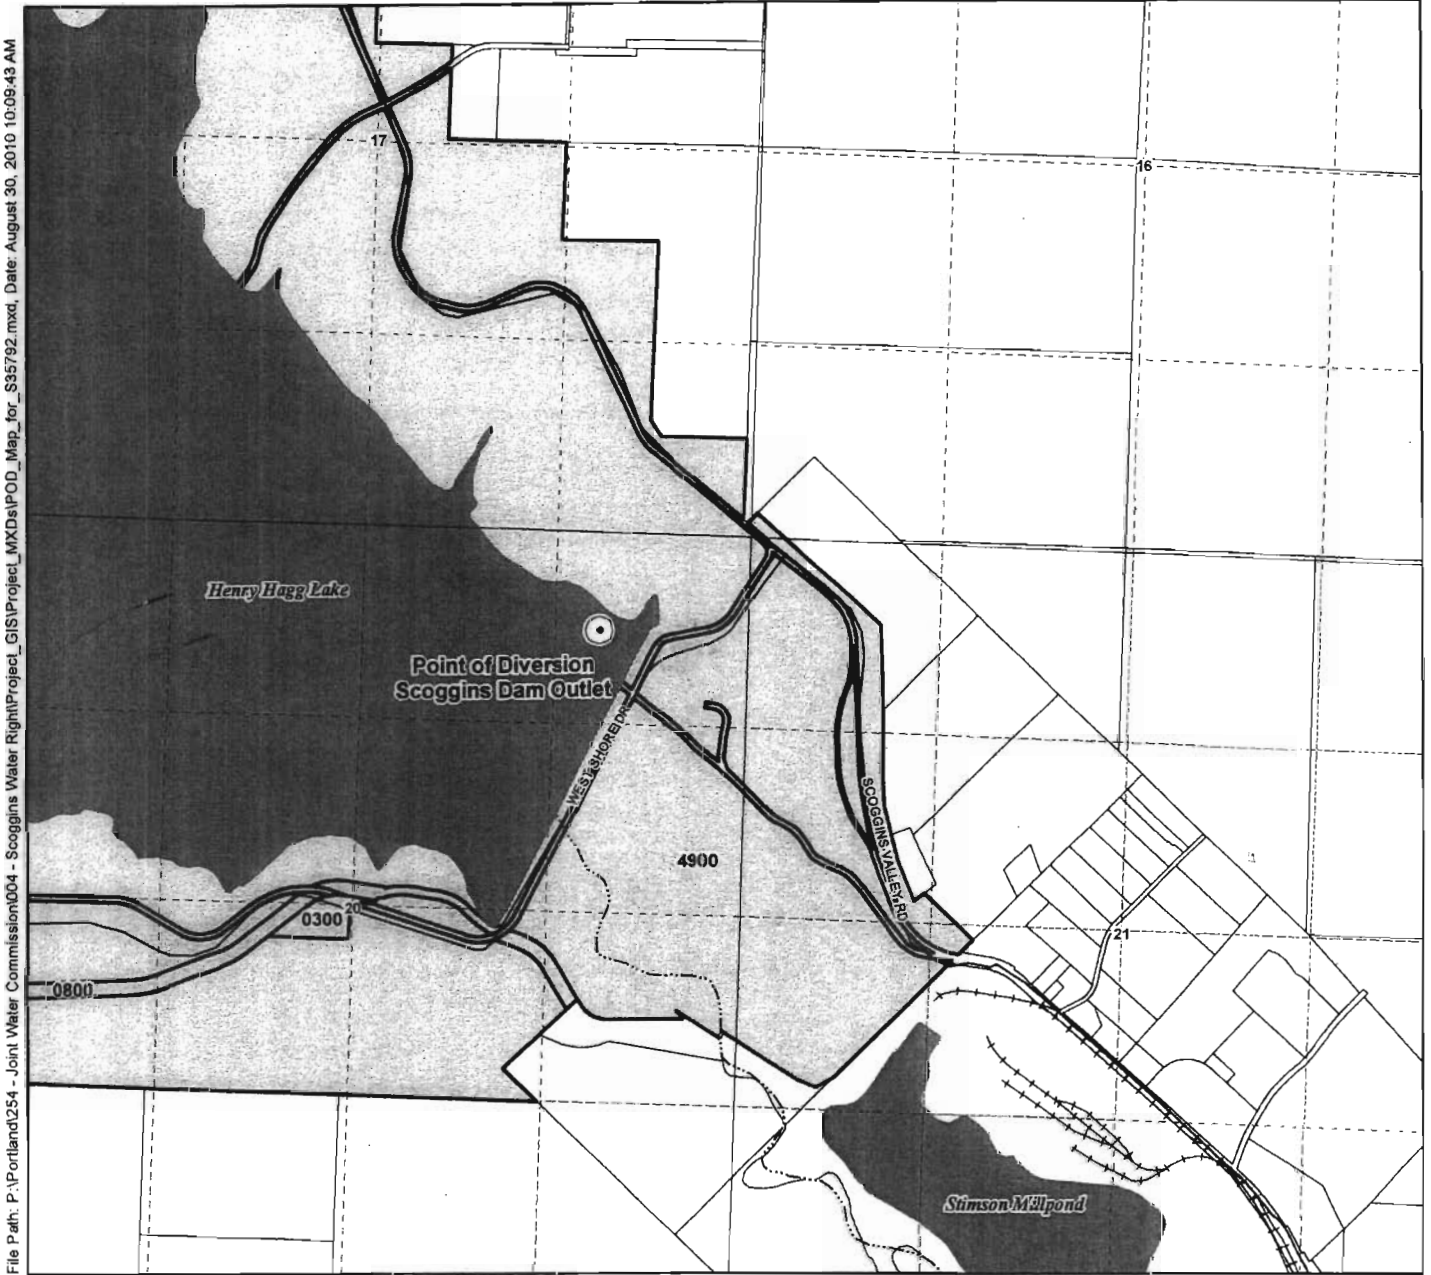

File Path: P:\Portland\254 - Joint Water Commission\004 - Scoggins Water Right\Project_GIS\Project_MXD\POD_Map_for_S35792.mxd, Date: August 30, 2010 10:09:43 AM

Legend

- ⊙ Point of Diversion (POD)
- ⊕ Taxlots
- ⊕ Taxlots owned by Bureau of Reclamation
- Roads
- +— Railroads
- ~ Watercourses
- ☪ Waterbodies


POD Legal Description

Scoggins Dam Located 700 feet South and 1030 feet West from the NE corner of Section 20, Township 1 South, Range 4 West (W.M.)

RECEIVED

SEP 01 2010

WATER RESOURCES
SALEM, ORE

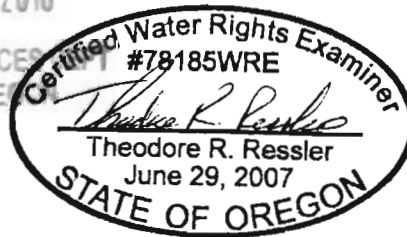

EXPIRES: 12-31-2010

Map Information


Projection: Oregon State Plane North Zone
Datum: North American Datum of 1983
Date: August 30, 2010
Prepared By: GSI Water Solutions, Inc.

Data Sources

OWRD, Oregon Geospatial Data Clearinghouse


Disclaimer

This map was prepared for the purpose of identifying the location of a water right only and it is not intended to provide legal dimensions or location of property ownership lines.

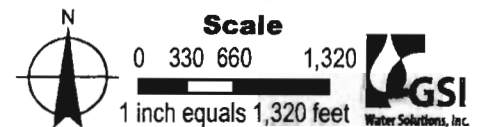

Claim of Beneficial Use Map Point of Re-Diversion

Permit S-35792 (Application S-38447)
Township 1 South, Range 3 West (W.M.)

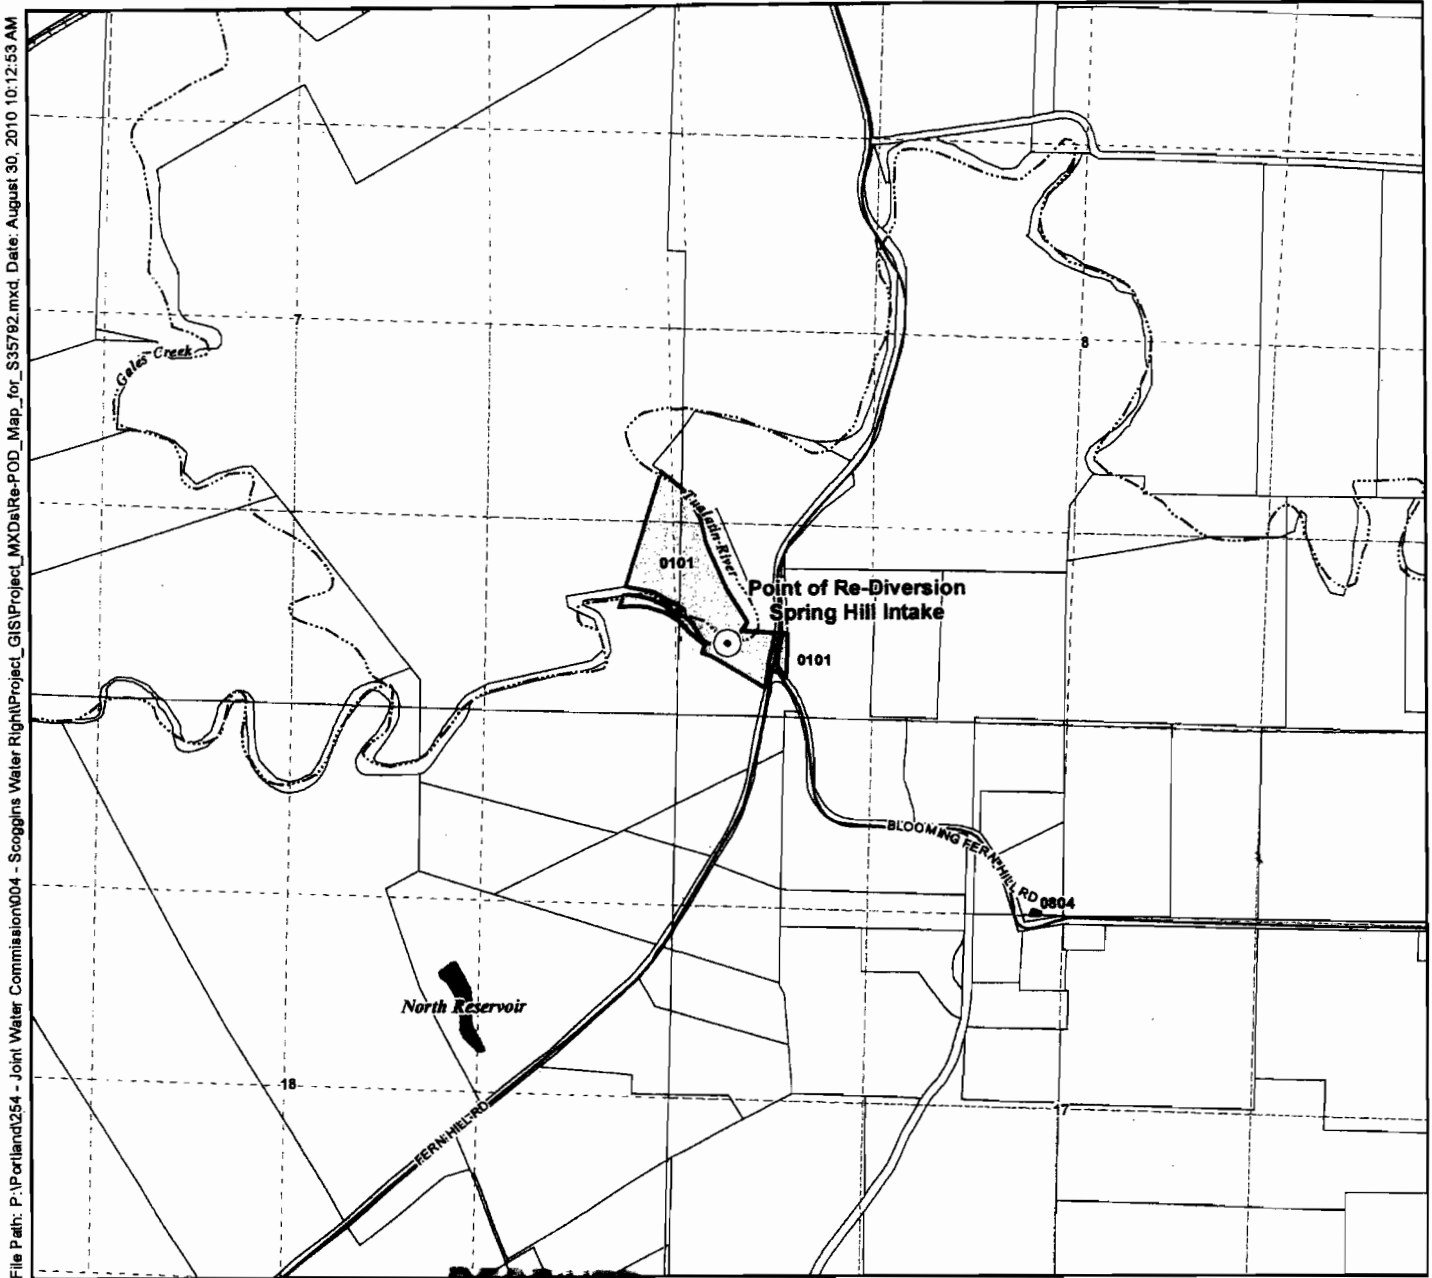

File Path: P:\Portland\254 - Joint Water Commission\004 - Scoggins Water Right\Project_GIS\Project_MXD\Re-POD_Map_for_S35792.mxd, Date: August 30, 2010 10:12:53 AM

Legend

- Point of Re-Diversion (POD)
- ⊕ Taxlots
- ⊕ Taxlots owned by Bureau of Reclamation
- Roads
- Railroads
- ~ Watercourses
- ◼ Waterbodies

POD Legal Description


Point of Re-Diversion Located 500 feet North and 410 feet East from the SW corner of Section 8, Township 1 South, Range 3 West (W.M.)

RECEIVED

SEP 01 2010

WATER RESOURCES DEPT

STATE OF OREGON

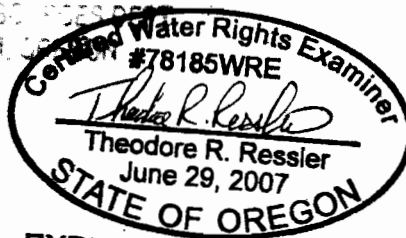

EXPIRES: 12-31-2010

Map Information

Projection: Oregon State Plane North Zone
Datum: North American Datum of 1983
Date: August 30, 2010
Prepared By: GSI Water Solutions, Inc.

Data Sources

OWRD, Oregon Geospatial Data Clearinghouse

Disclaimer

This map was prepared for the purpose of identifying the location of a water right only and it is not intended to provide legal dimensions or location of property ownership lines.




Scale


0 330 660 1,320

1 inch equals 1,320 feet



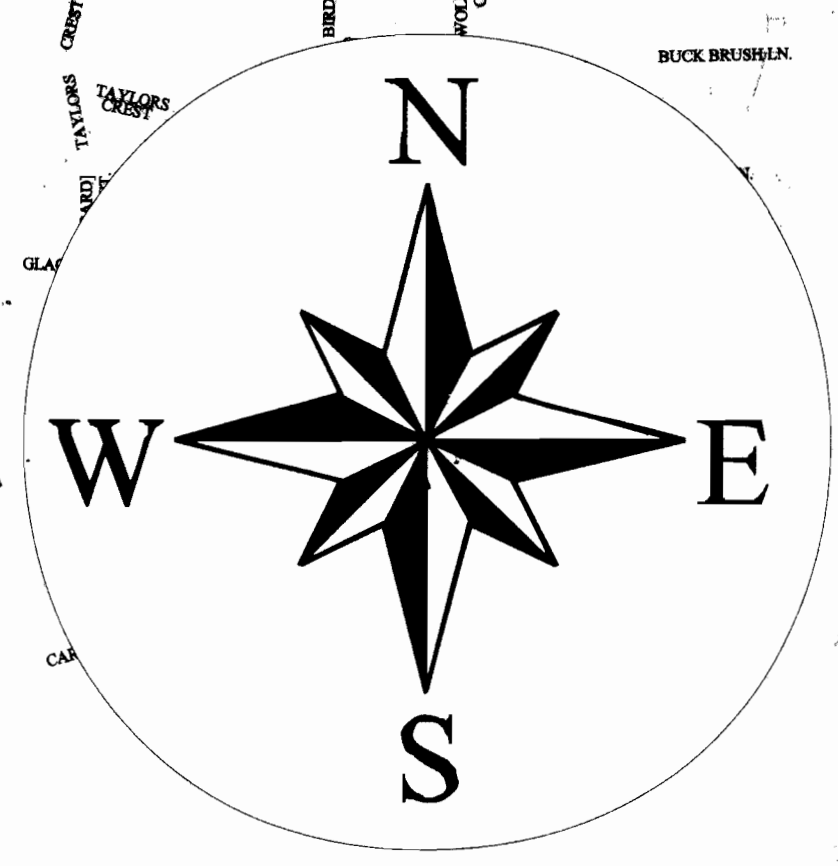

TOWNSHIP 2 SOUTH, RANGE 1 EAST, W.M.

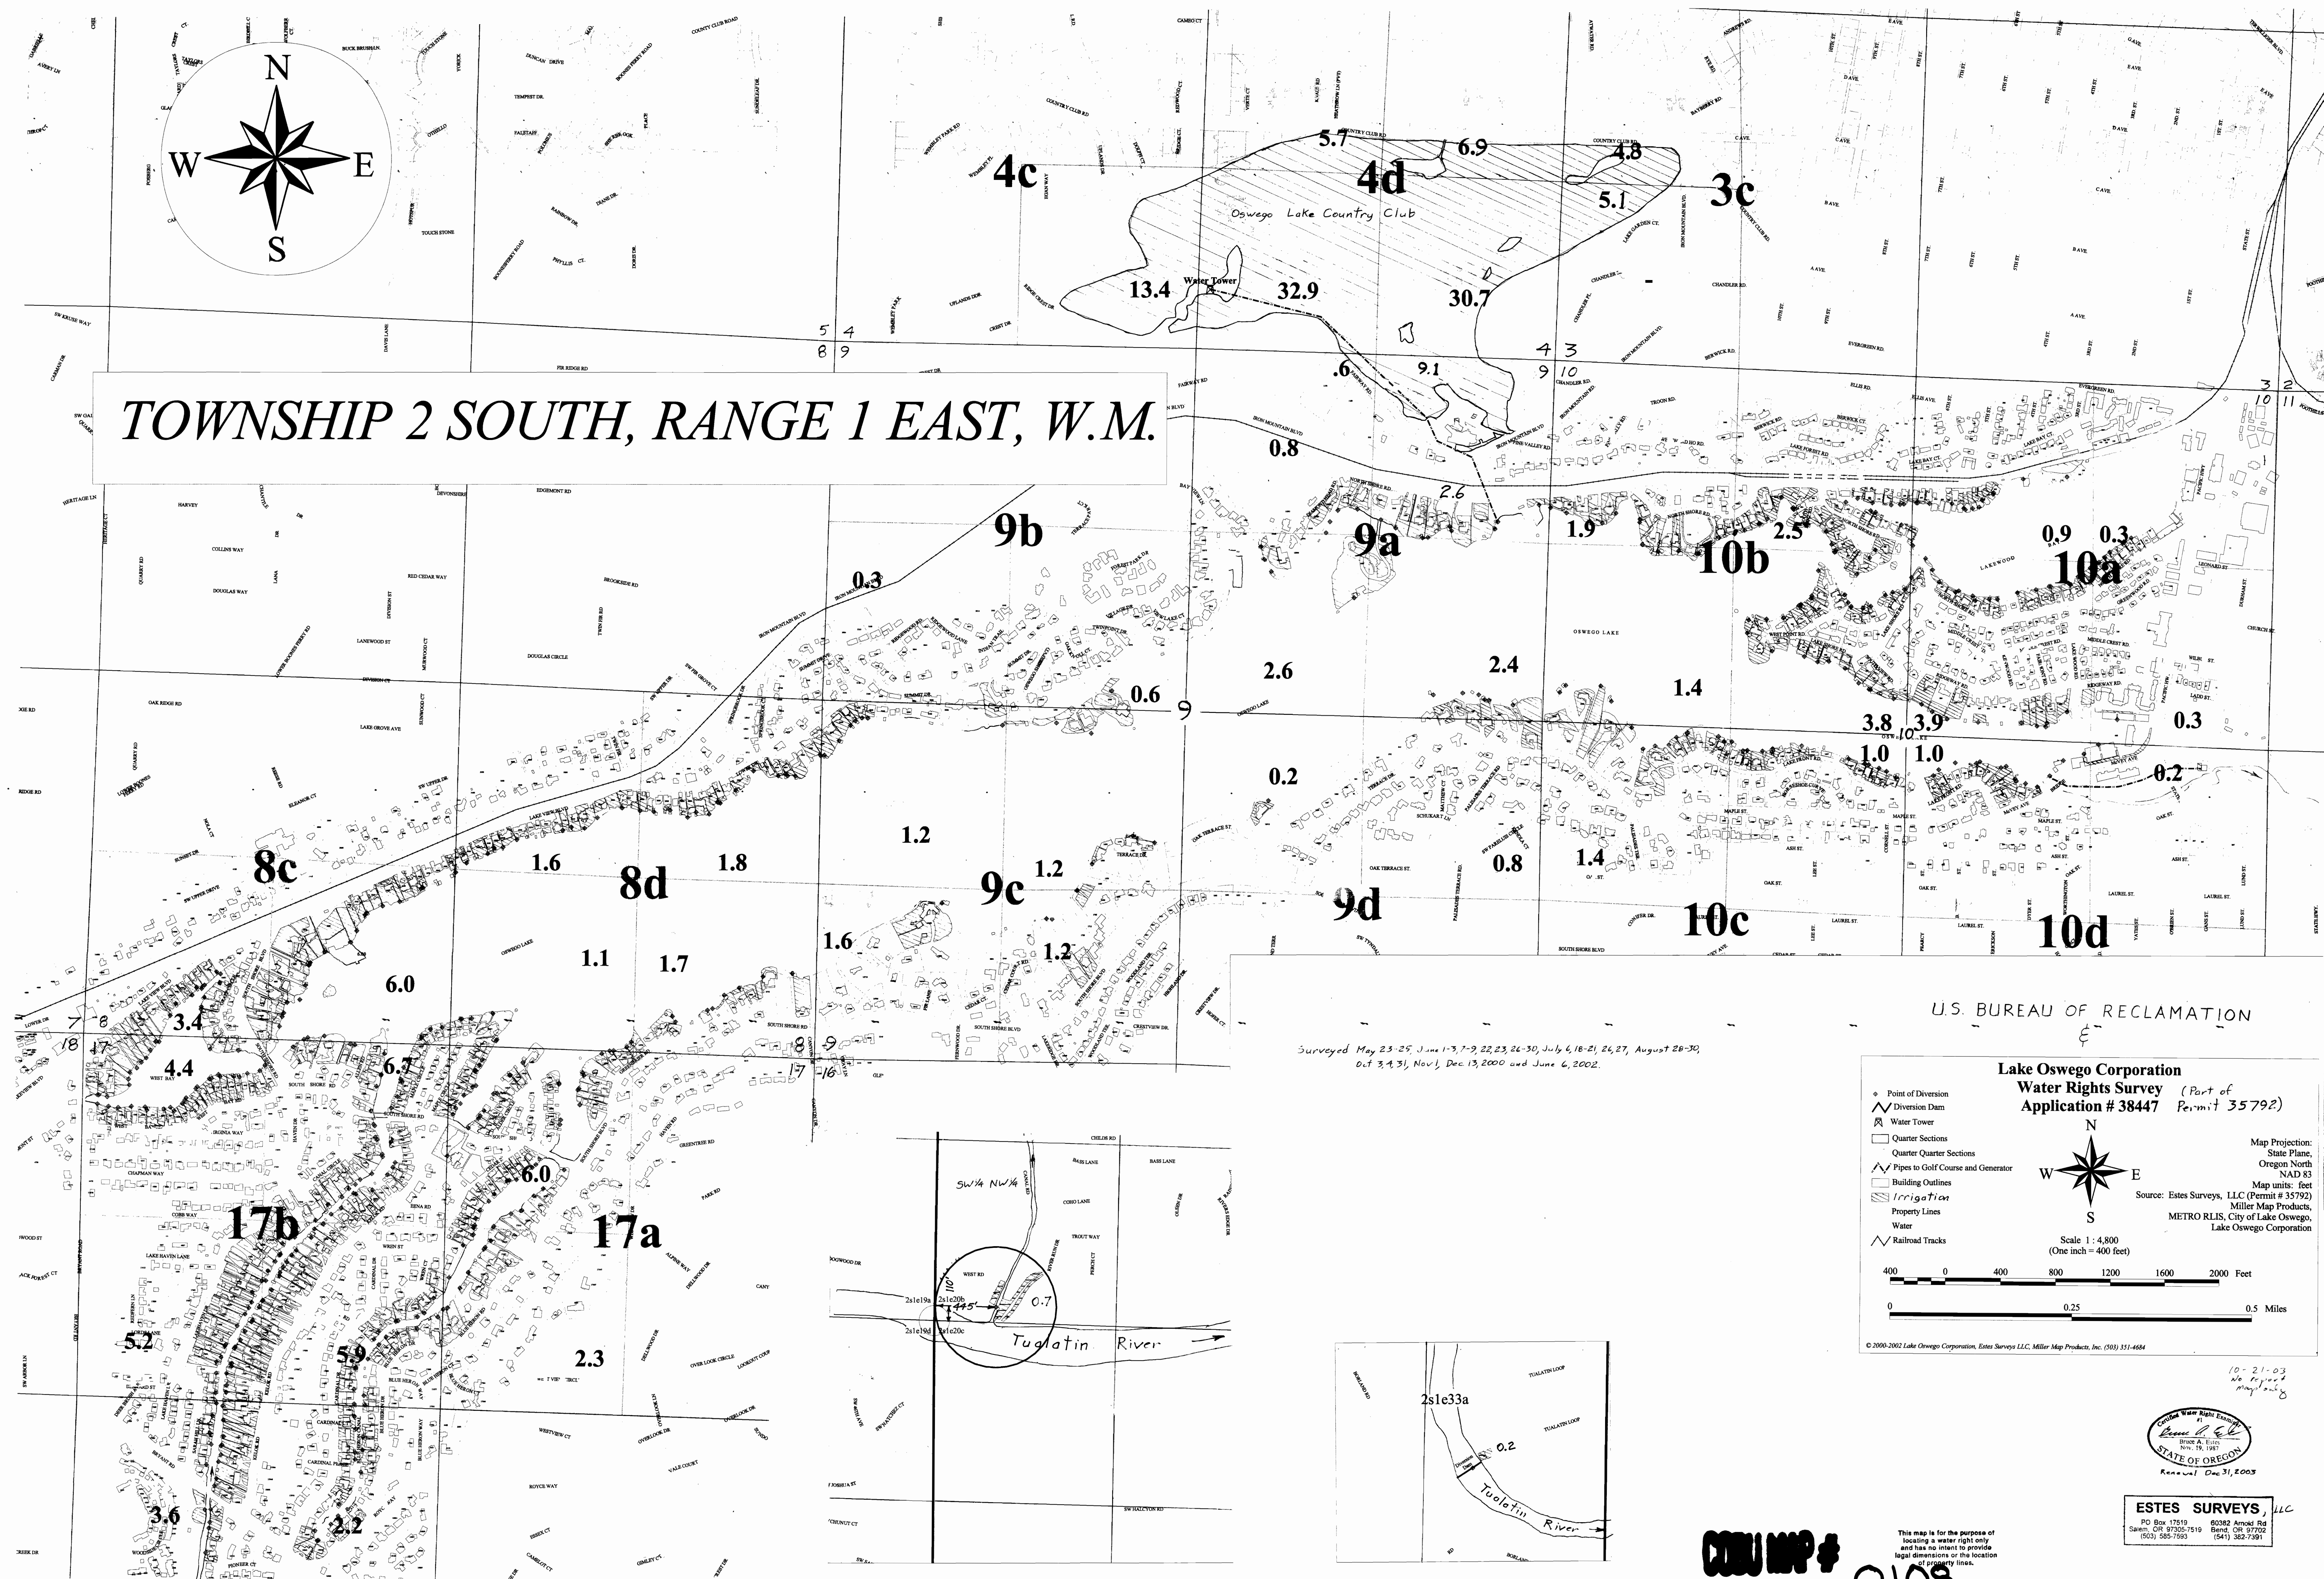

Surveyed May 23-25, June 1-3, 7-9, 22, 23, 26-30, July 6, 18-21, 24, 27, August 28-30, Oct 3, 4, 31, Nov 1, Dec 13, 2000 and June 6, 2002.

U.S. BUREAU OF RECLAMATION



Lake Oswego Corporation
Water Rights Survey (Part of Application # 38447 Permit 35792)

Map Projection: State Plane, Oregon North NAD 83
 Map units: feet (One inch = 400 feet)
 Source: Estes Surveys, LLC (Permit # 35792) Miller Map Products, METRO RLIS, City of Lake Oswego, Lake Oswego Corporation


Scale 1 : 4,800 (One inch = 400 feet)

0 400 800 1200 1600 2000 Feet
 0 0.25 0.5 Miles

© 2000-2002 Lake Oswego Corporation, Estes Surveys LLC, Miller Map Products, Inc. (503) 351-4584

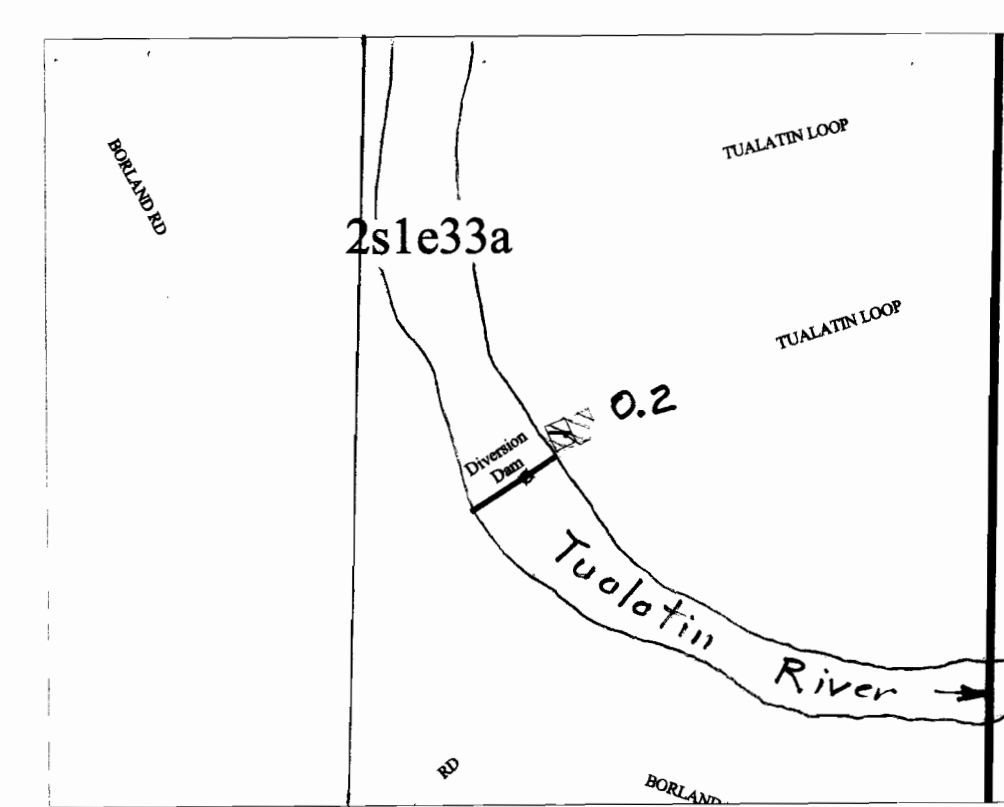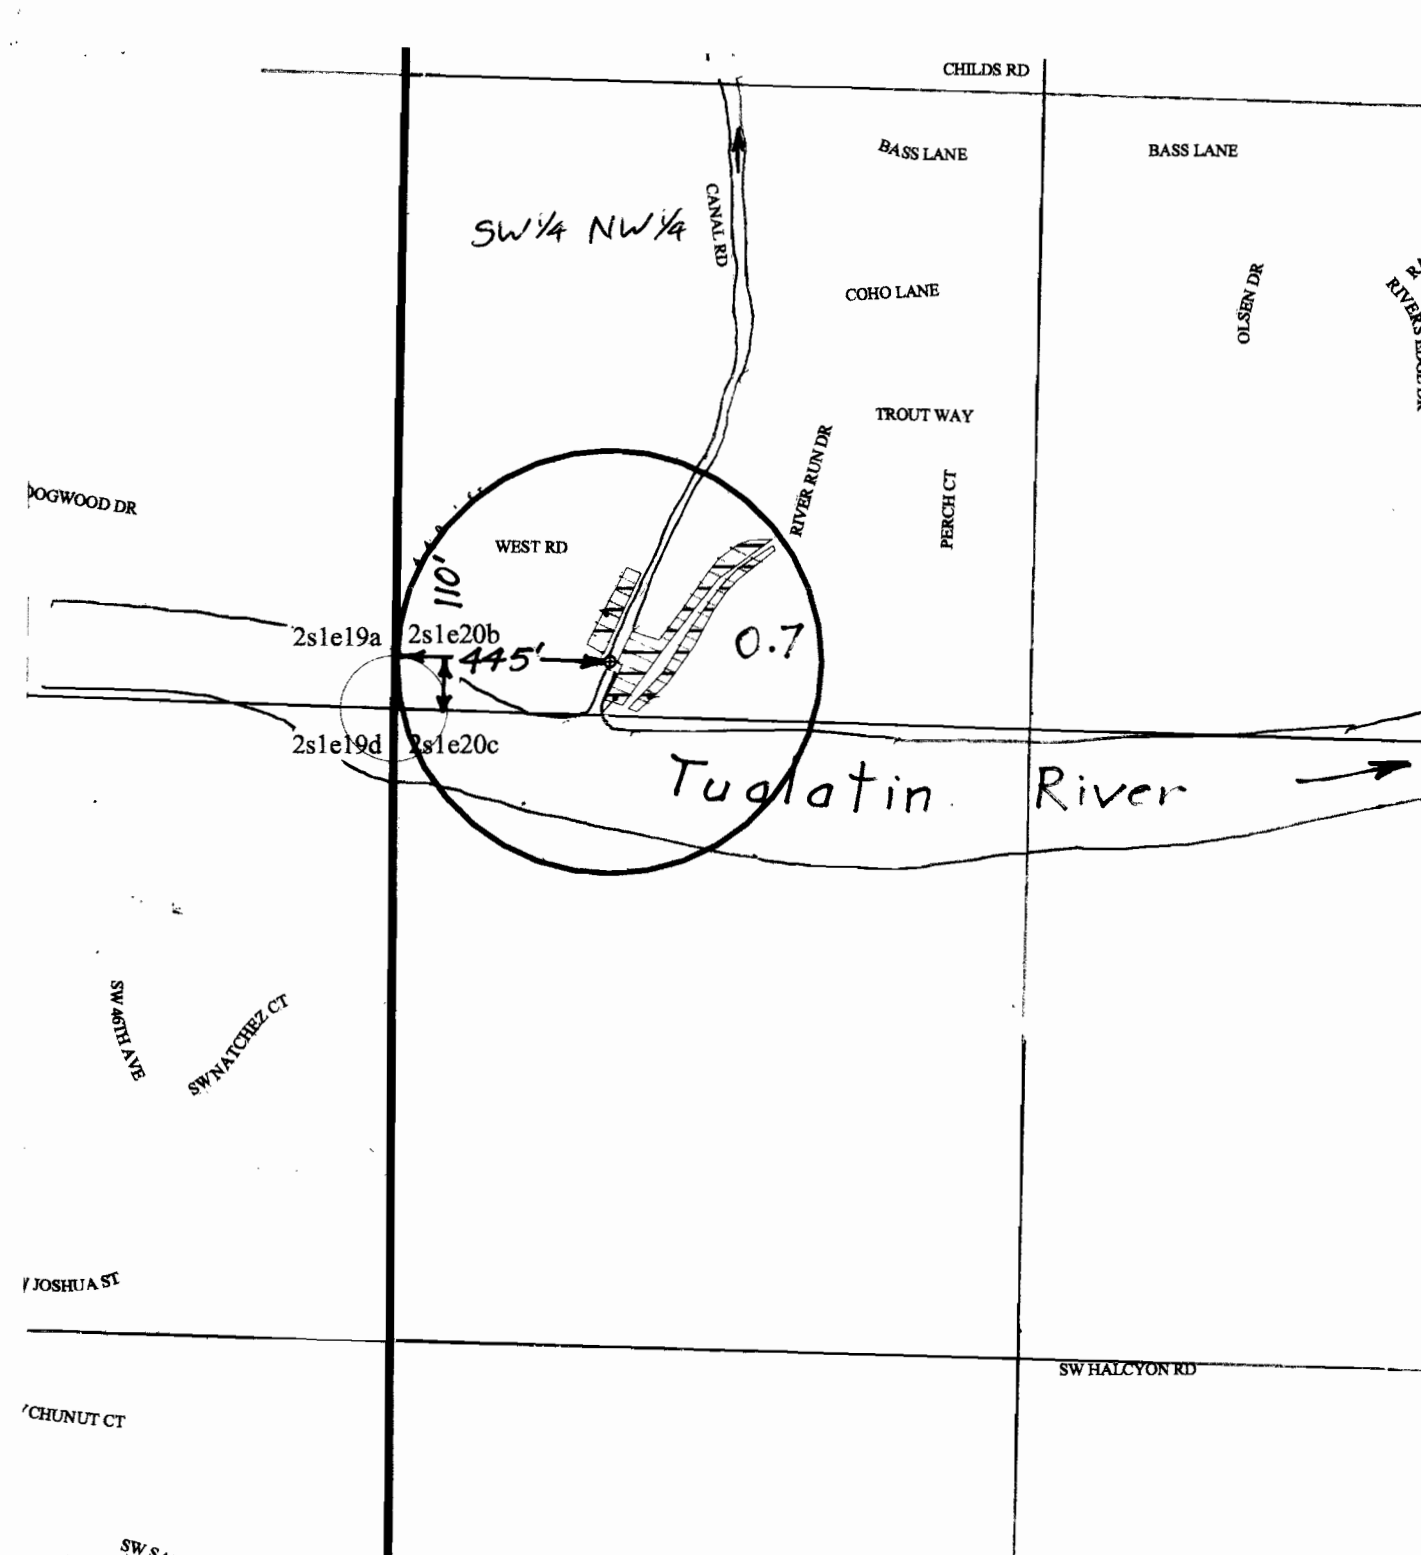

COU MAP # 0108

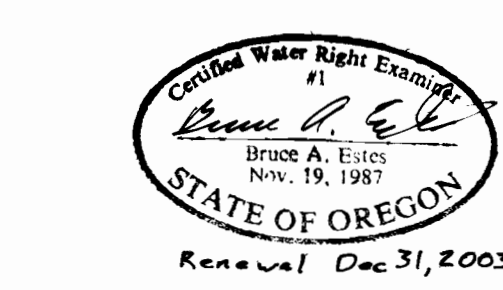

ESTES SURVEYS, LLC
 PO Box 17519 60382 Arnold Rd
 Salem, OR 97305-7519 Bend, OR 97702
 (503) 585-7993 (541) 382-7391

This map is for the purpose of locating a water right only and has no intent to provide legal dimensions or the location of property lines.