
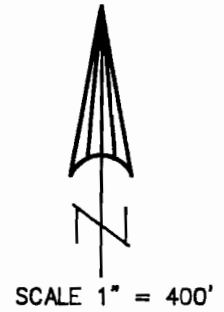


T.34S.,R.1W.,W.M.



RECEIVED

JAN 22 1999

WATER RESOURCES DEPT.
SALEM, OREGON

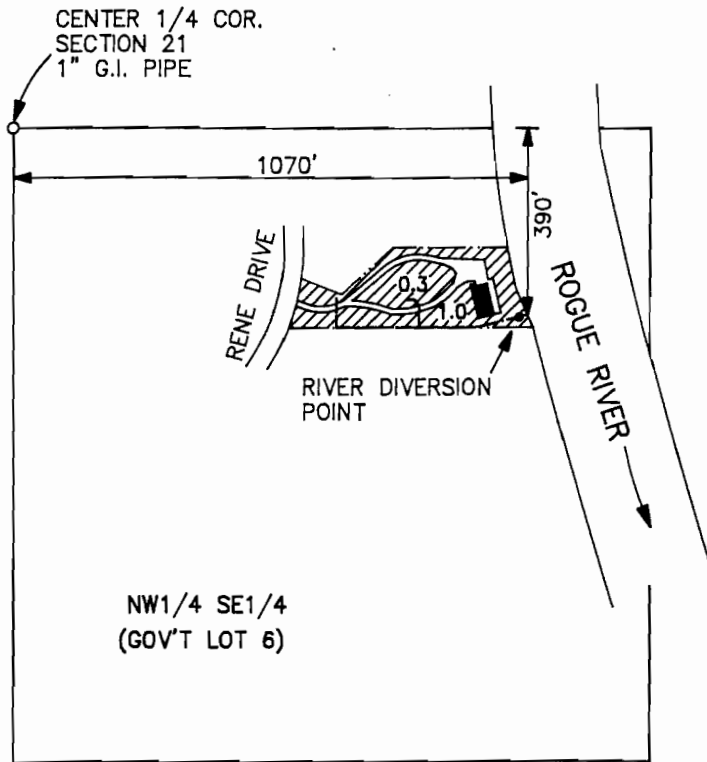

NOTE: MAP PREPARED FOR
WATER RIGHT PURPOSES ONLY,
NOT FOR PROPERTY BOUNDARY
LOCATIONS.

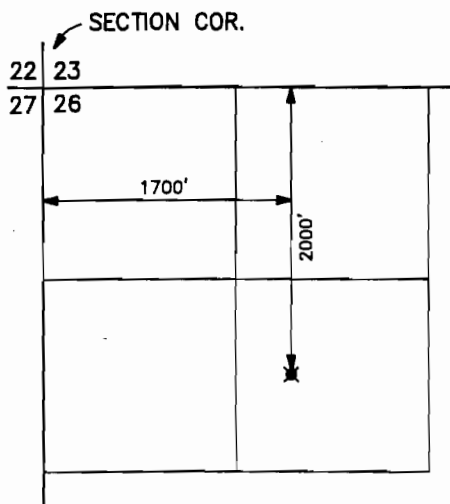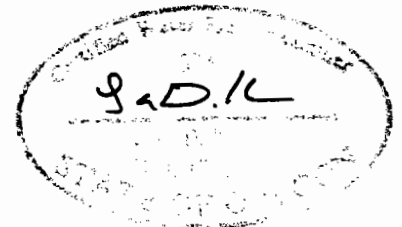

LOST CREEK RESERVIOR
POINT OF DIVERSION
T.33S.,R.1E.,W.M.
SCALE 1" = 1320'

FINAL PROOF MAP

APPLICATION No. S-80700
PERMIT No. 53187

IN THE NAME OF
KENNETH PAYZANT

MAP PREPARED JANUARY 8, 1999 BY GARY D. KAISER