

**RECEIVED**


T6N, R35E, WM

JAN 15 1999

WATER RESOURCES DEPT.  
SALEM, OREGON



SCALE = 1" : 500'

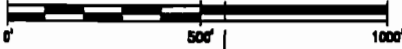

Well 1

Use this map only for the purpose of identifying the location of the well. The place of use is identified on the map for the Hudson Bay District Improvement Company HB 3111 map.

*DC WRD  
8-8-2011*

Tax Lot 801

Tax Lot 500

Tax Lot 506

WINE GRAPES  
IRRIGATION  
24.0 ACRES

10.9 ACRES

13.1 ACRES

DIVERSION POINT(S):

WELL 1:

Located 70 feet West and 30 feet South from the NE corner, of the NE 1/4, of the SE 1/4, Section 32, T6N, R35E, WM.

N 0, 20', 59" E

N 41, 23', 56" W

32 33  
5 4



Exhibit B

FINAL PROOF SURVEY

Application #G-13759

Permit #G-12598

In The Name Of:

McKibben Family Limited Partnership

Surveyed, Jan. 7, 1999, by John Warinner

**Project Name:**  
MFLP  
Walla Walla, WA  
**Project No.** 98-21  
**Date:**  
01-08-99



**Fountainhead  
Irrigation, Inc.**

PO Box 2197 Walla Walla, WA 99362  
Phone (509) 529-2646 Fax (509) 522-5251