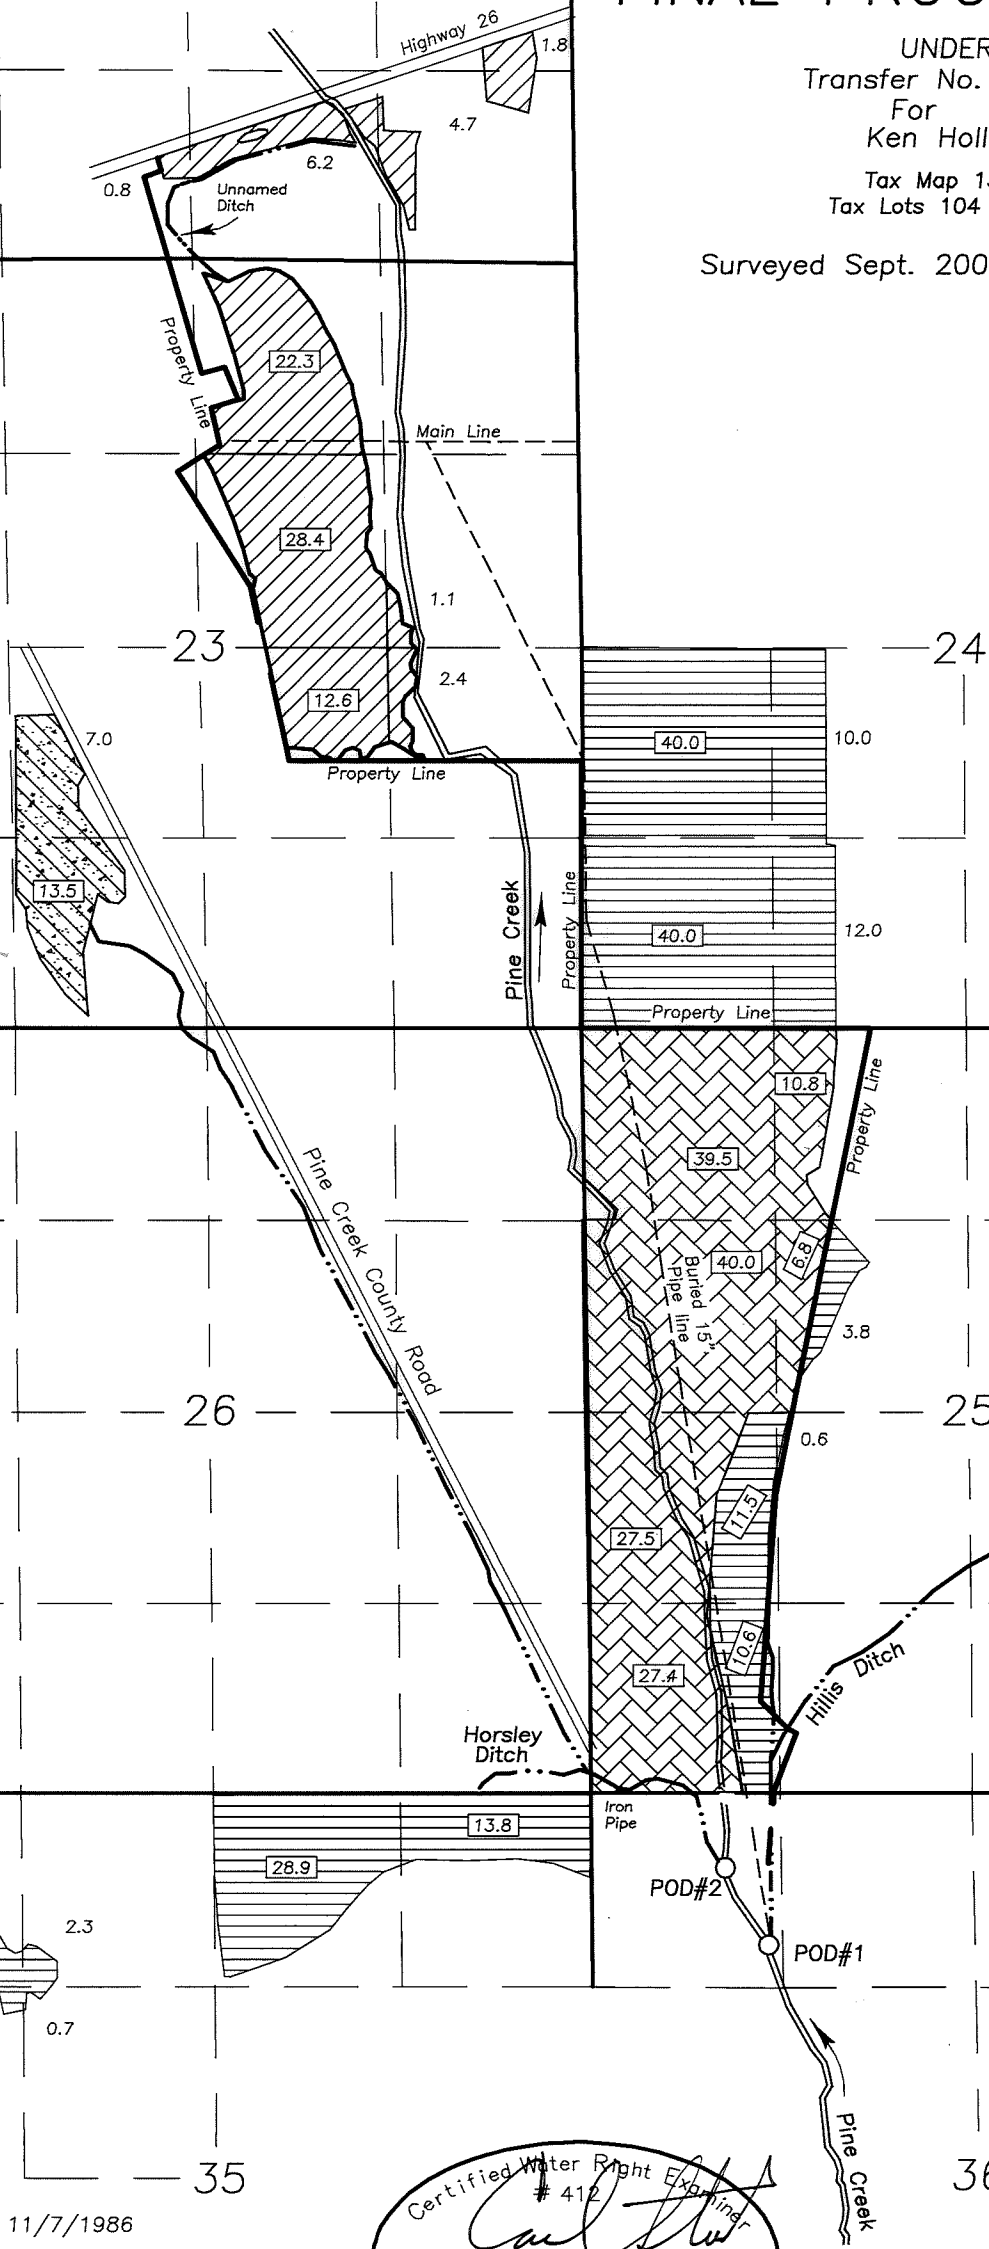


T13S, R32E, W.M.

# FINAL PROOF SURVEY

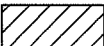
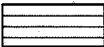
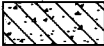

UNDER  
Transfer No. T-7438  
For  
Ken Holliday  
Tax Map 13-32  
Tax Lots 104 & 2300

Surveyed Sept. 2007 - May 2010



Scale 1"=1320'

RECEIVED  
JUN 13 2011  
WATER RESOURCES DEPT  
SALEM, OREGON

-  Priority 11/7/1986
-  C 80463 Priority 11/7/1986 Remaining Right
-  C 80463 Priority 11/7/1986 Additional POD Horsley Ditch
-  C 80463 Priority 11/7/1986 Additional POD Hillis Ditch

Certified Water Right Examiner  
# 412  
*Carl Stout*  
Carl Stout  
May 16, 1995  
STATE OF OREGON

This map is not intended to provide legal dimensions or locations of property ownership lines.

POD#1 Hillis Ditch 750'S & 1140'E  
Concrete headgate is at the POD  
Fish screen is 50' downstream in ditch

POD#2 Horsley Ditch 350'S & 1000'E  
Concrete headgate is at the POD  
Fish screen is 65' downstream in ditch

Coordinates are from the NW corner of Section 36, T13S, R32E, W.M.