

# Claim of Beneficial Use Map Water Right in the Name of International Paper

Transfer T-8792 (Permit S-17511)

Township 17 South, Range 2 West (W.M.)

RECEIVED

NOV 2 2 2011

WATER RESOURCES DEPT  



File Path: P:\Portland\385 International Paper\001-WR Transfer\Project GIS\Project mxd\COBU\Transfer T8792.mxd

**LEGEND**


- Point of Diversion (POD)
- Place of Use (POU)
- Water Mainline
- DLC
- Government Lot
- Tax Lot
- Waterbody
- Watercourse

**POD Location Descriptions**

**New POD**  
Located 1,695 feet North and 2,530 feet East from the SW corner of Section 29, Township 17 South, Range 2 West (W.M.)

**Original POD**  
Located 80 feet North and 1,510 feet East from the SW corner of Section 29, Township 17 South, Range 2 West (W.M.)

**Certified Water Rights Examiner Stamp**

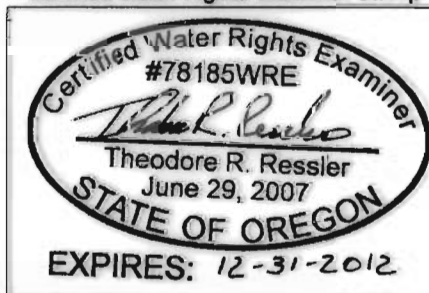

**Disclaimer**  
This map was prepared for the purpose of identifying the location of a water right only and it is not intended to provide legal dimensions or location of property ownership lines.

**Map Notes**  
Date: July 14, 2011  
Data Sources: Lane County GIS, OGIC  
Prepared By: GSI Water Solutions, Inc.

