


T38S R5W

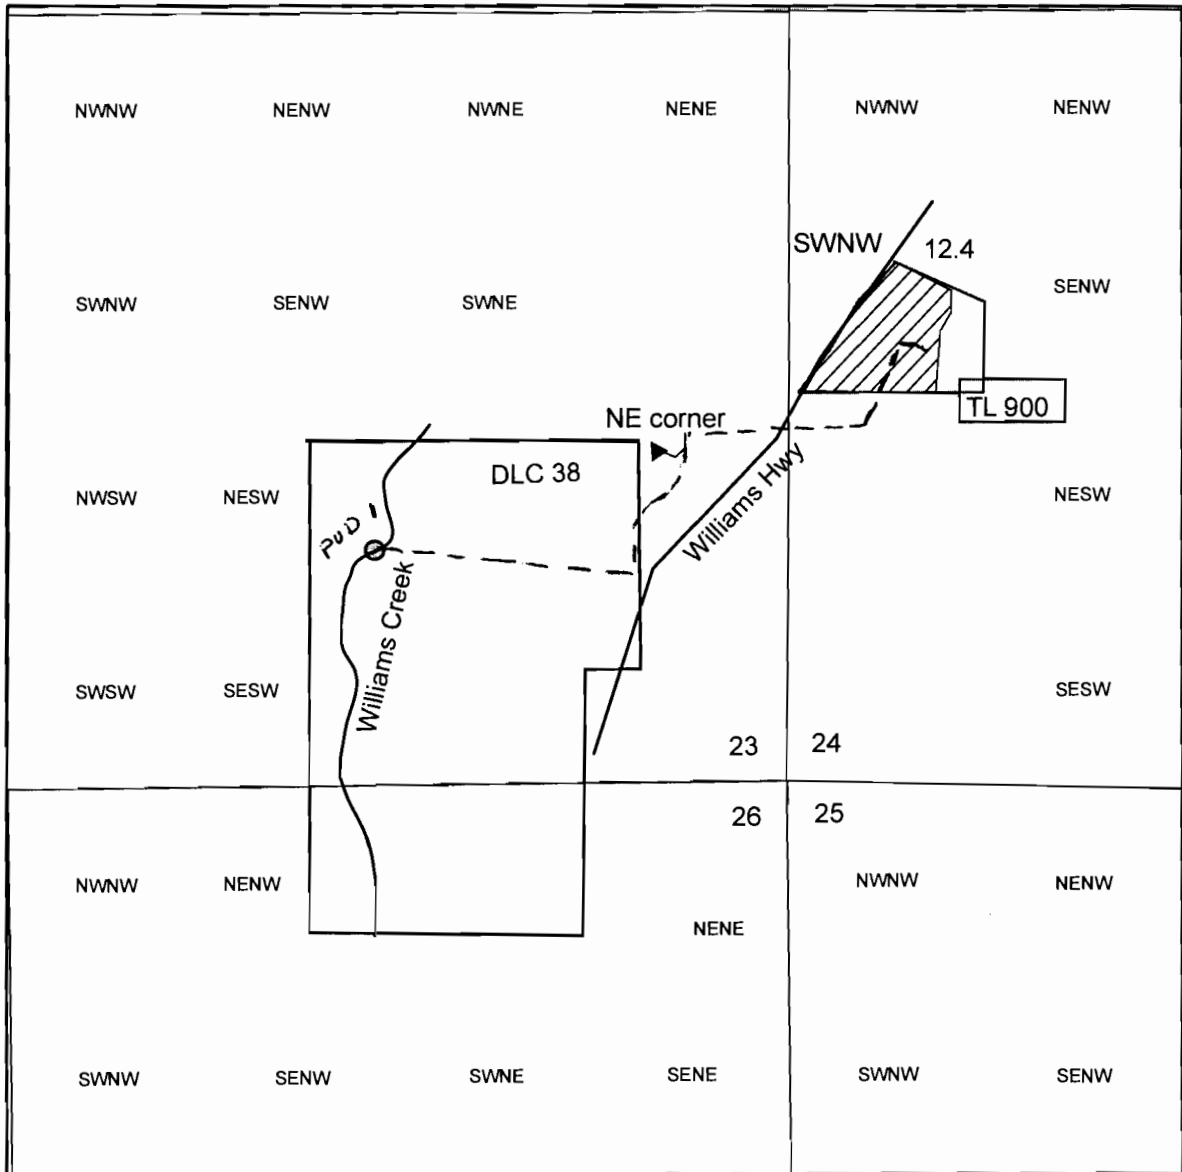

1 inch = 1,320 feet

Historic POD is 650 ft south and 1820 feet west from NE corner Shouldy DLC 38
 (POD is in TL 700)

--- irrigation pipe

Authorized POD
 Baltimore ditch

RECEIVED

SEP 06 2011

WATER RESOURCES DEPT
 SALEM, OREGON

T 11291

