


T. 4N. R. 28E. W.M.

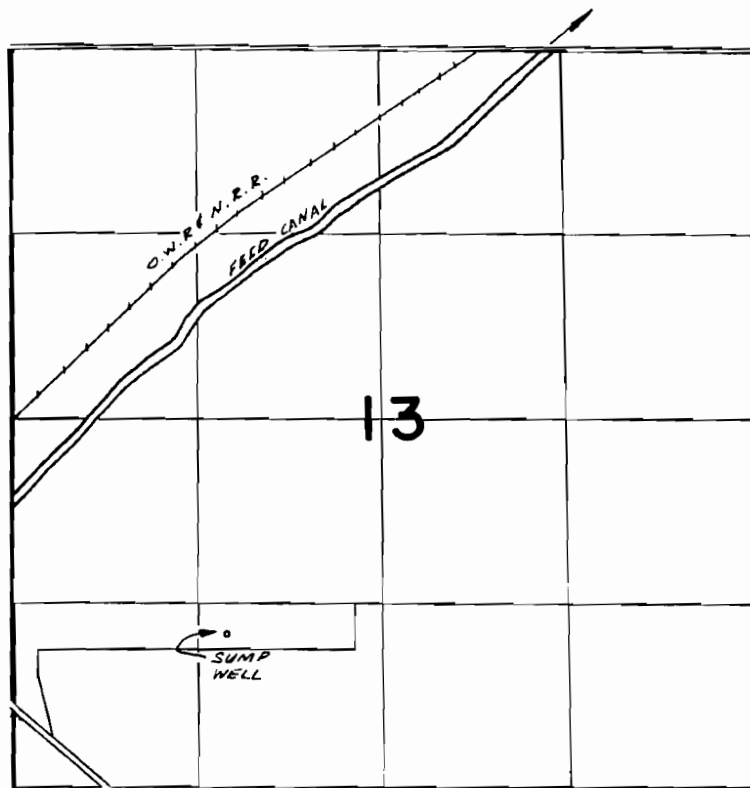

WELL LOCATED 1100' N. & 1110' W. FROM SW COR SEC 13

FINAL PROOF SURVEY
UNDER

TRANSFER 3327

Application No. Permit No.
IN NAME OF

..... **CECIL D. THOMPSON**

Surveyed 11-30 1977, by R. BARWIN