


T39S R5W

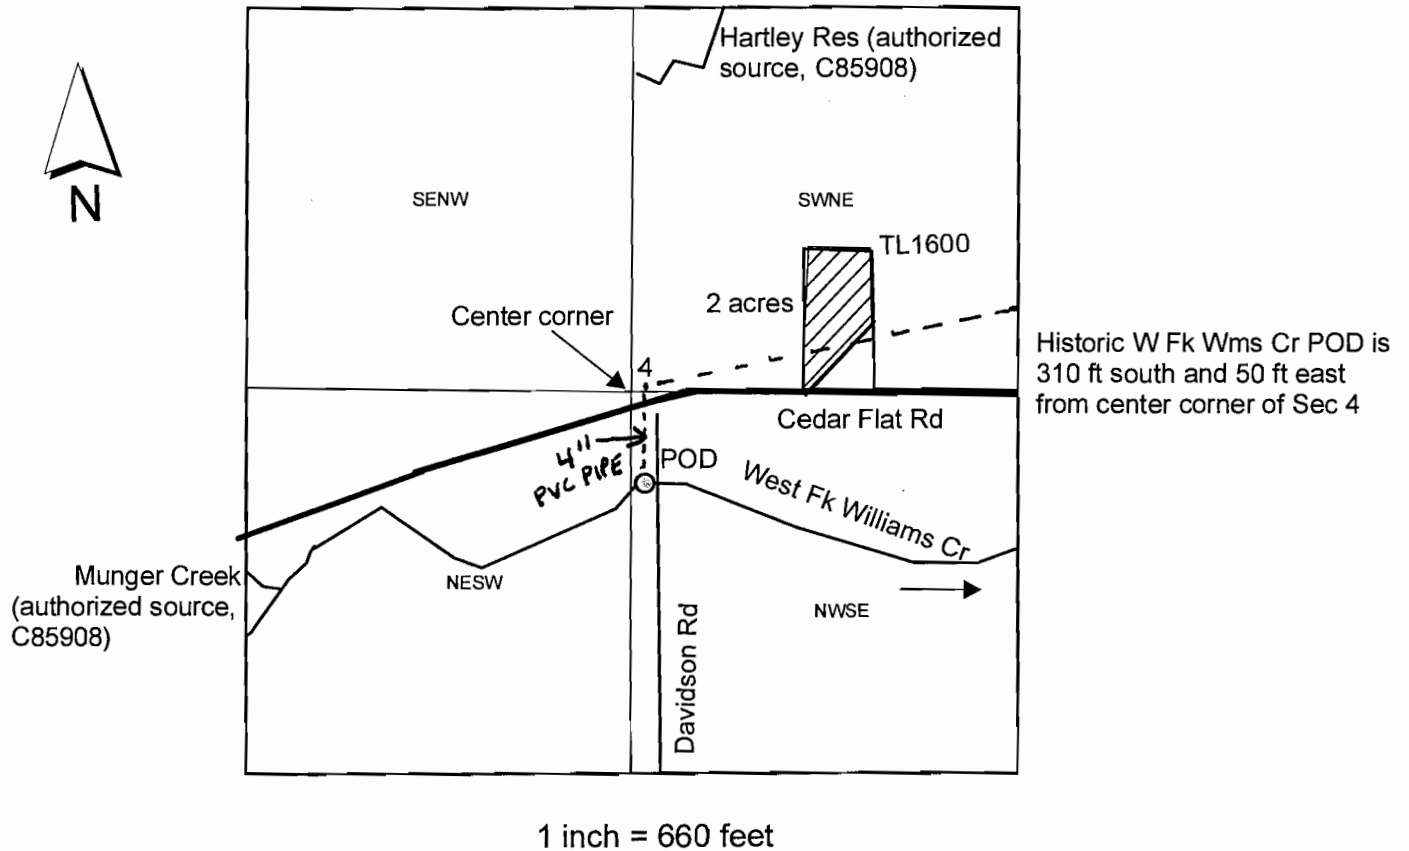

Transfer Historic POD Change

RECEIVED

SEP 15 2011

WATER RESOURCES DEPT
SALEM, OREGON

T 11296