


T.39S.R.11E.W.M.

East River Misc.

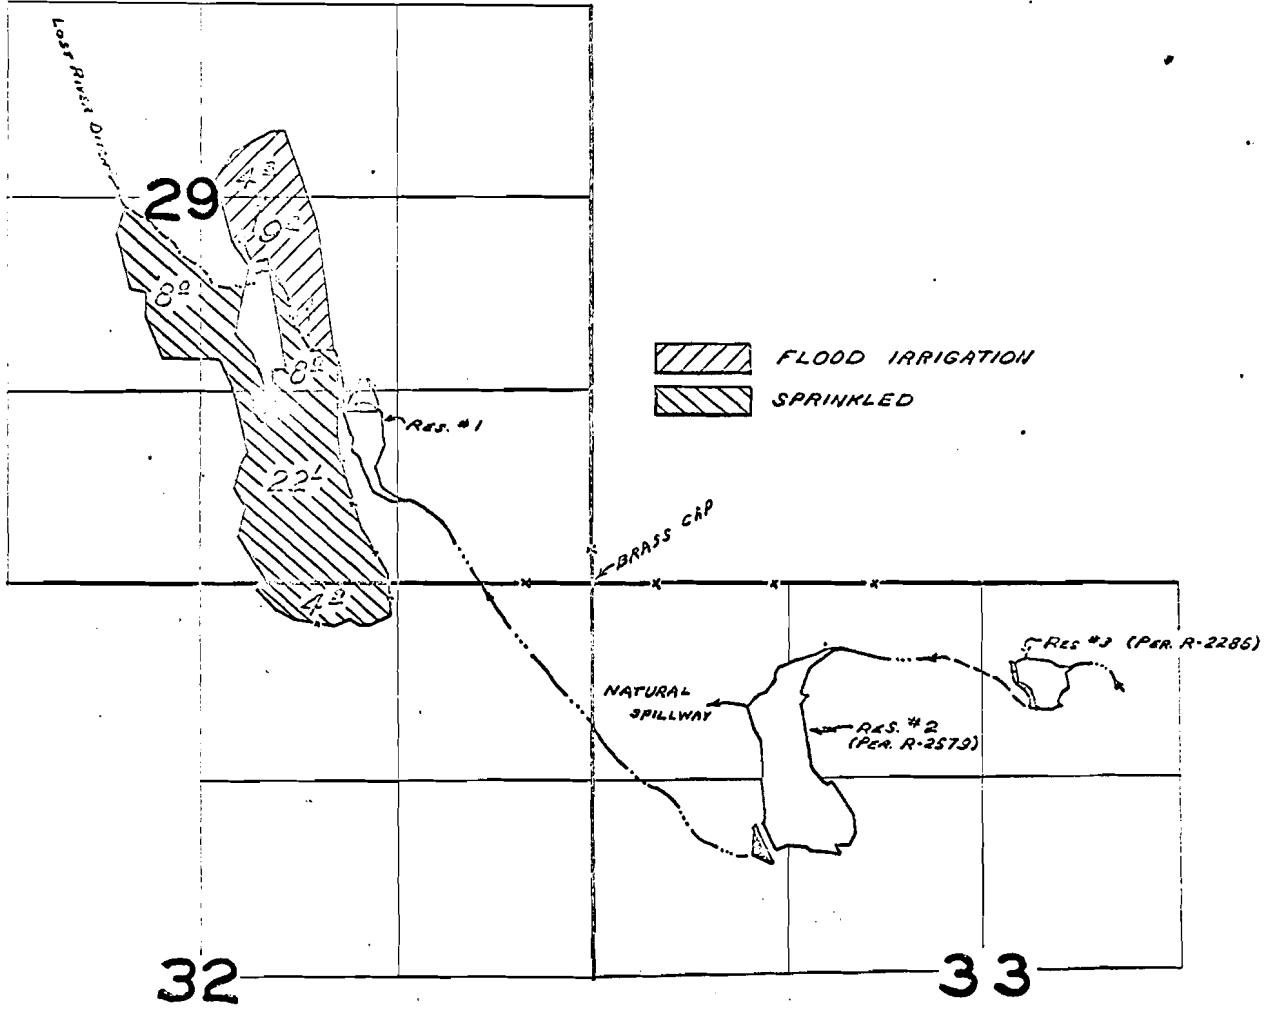

FINAL PROOF SURVEY  
UNDER

Application No. R-33300 Permit No. R-2286  
33301 26705  
R-34491 R-2579  
34492 27136

IN NAME OF

**R. T. WILLIAMS**

Surveyed JUN 16 1964 by R. JACKSON