


26405
34771

T.39S.R.11E.W.M.

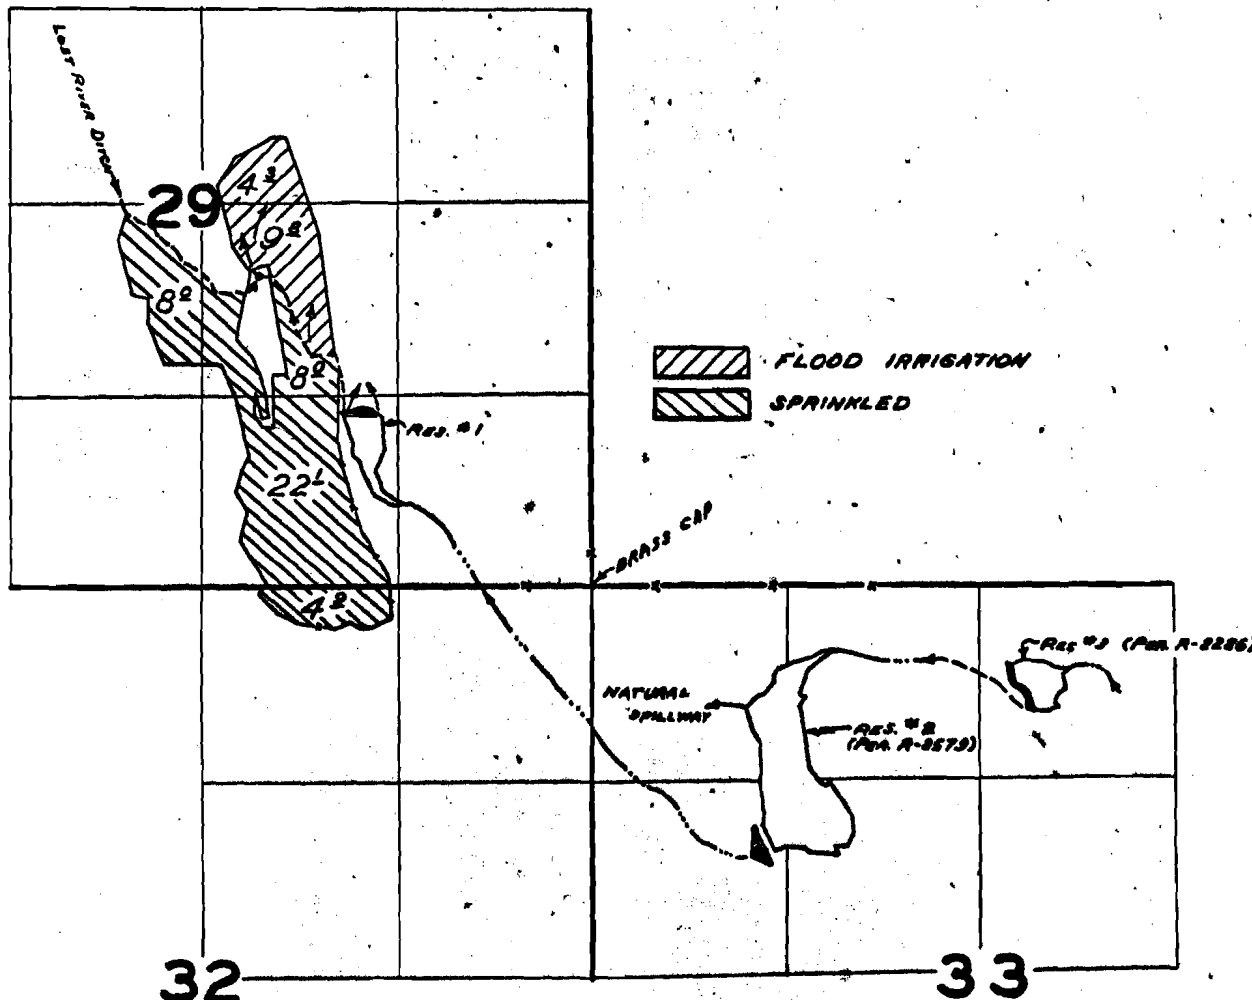


FINAL PROOF SURVEY UNDER

Application No.	R-33300 33301 R-34491 34492	Permit No.	R-2286 26405 R-2579 27136
-----------------	--------------------------------------	------------	------------------------------------

IN NAME OF

R. T. WILLIAMS

Surveyed Jun 16 1964, by R. JACKSON