


1" = 1 mile

POB-located 2140'S & 3100'W from EK corner Section 35, T.6S., R.7W., W.M.

Mt. Springs Ranch Reservoir

 Area Served

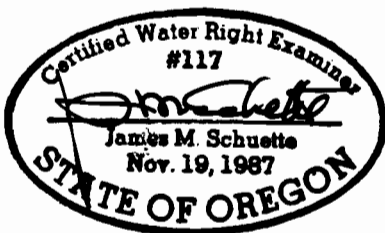

### Final Proof Survey

Transfer #: T-6287

In Name Of

# Buell-Red Prairie Water Association

Surveyed on September 28, 1997 by JM Schuette

**RECEIVED**

**SEP 30 1997**

WATER RESOURCES DEPT.  
SALEM, OREGON

THIS MAP WAS PREPARED FOR THE PURPOSE OF IDENTIFYING THE LOCATION OF A WATER RIGHT ONLY AND IS NOT INTENDED TO PROVIDE LEGAL DIMENSIONS OR LOCATION OF PROPERTY OWNERSHIP LINES.