


T.14S.,R.12E.,W.M.

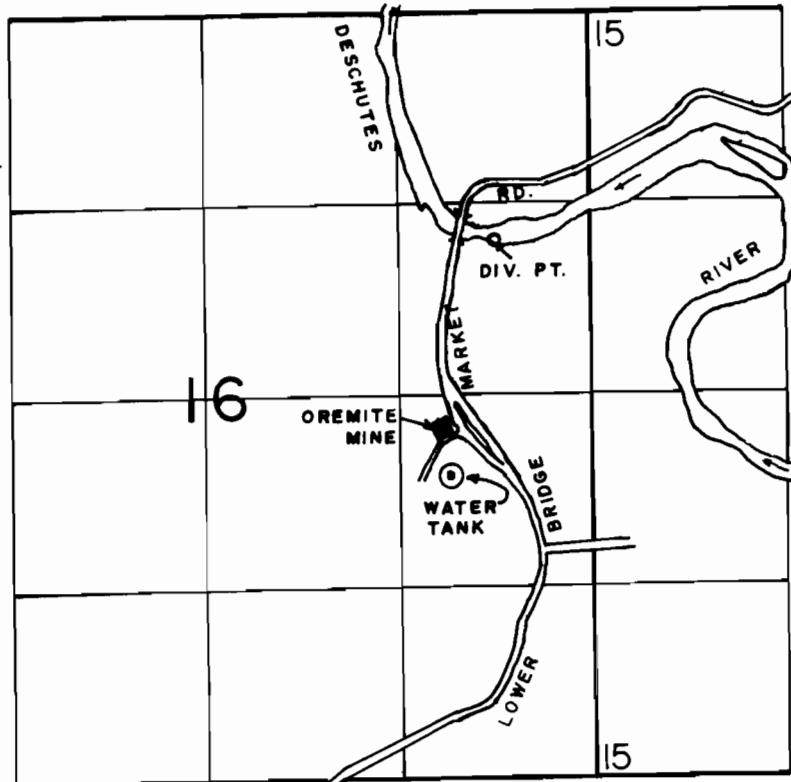

DIV.PT. LOC.: 1570' S. & 650' W. FROM NE COR. SEC. 16.

SCALE: 1" = 1320'

**FINAL PROOF SURVEY  
UNDER**

TRANSFER NO. 5647

No. .... Permit No. ....  
**IN NAME OF**

..... **FRED GUNZNER** .....

**Surveyed AUG. 21, 19.91., by B.W. BISHOP...**